


T.12S. R.3 W.W.M.

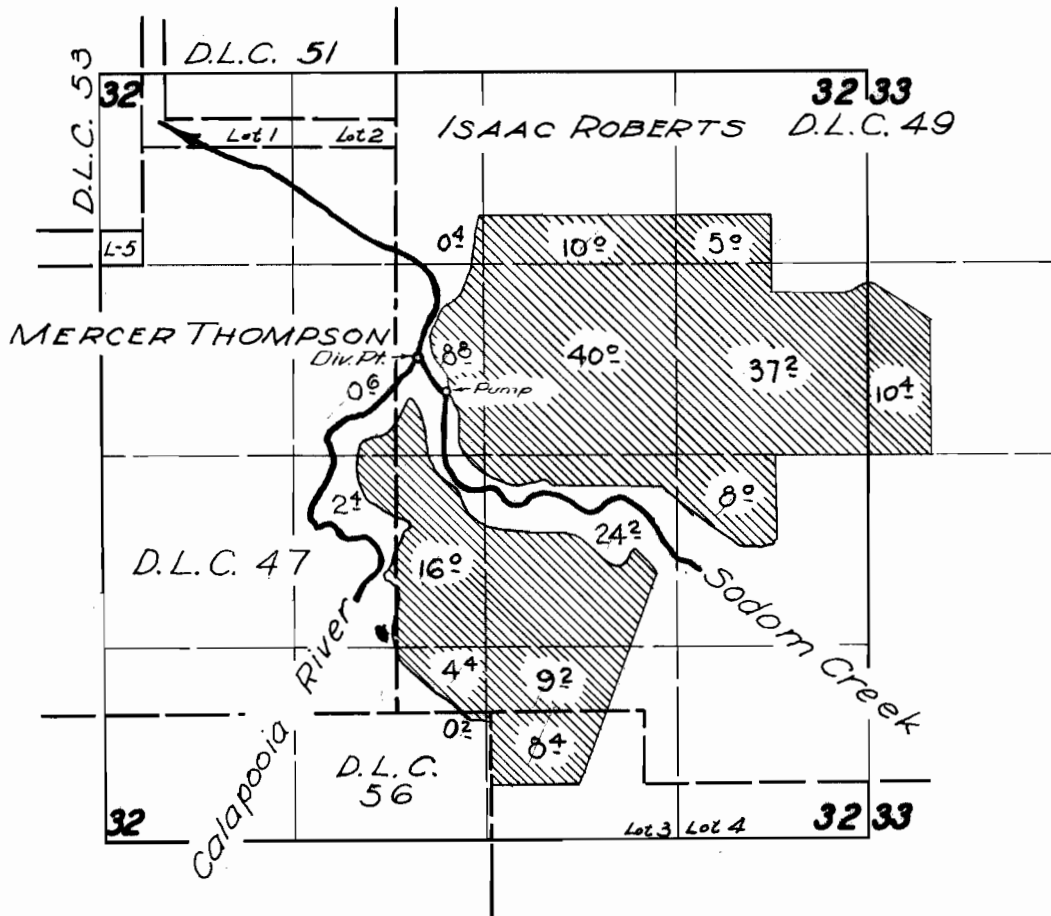

FINAL PROOF SURVEY
UNDER

Application No. 23461. Permit No. 18569.
IN NAME OF

LEONARD W. & BETTY JEAN FORSTER

Surveyed 15 July 1958, by C.O. Bartels.