


# T.8 S.R.6 W.W.M.

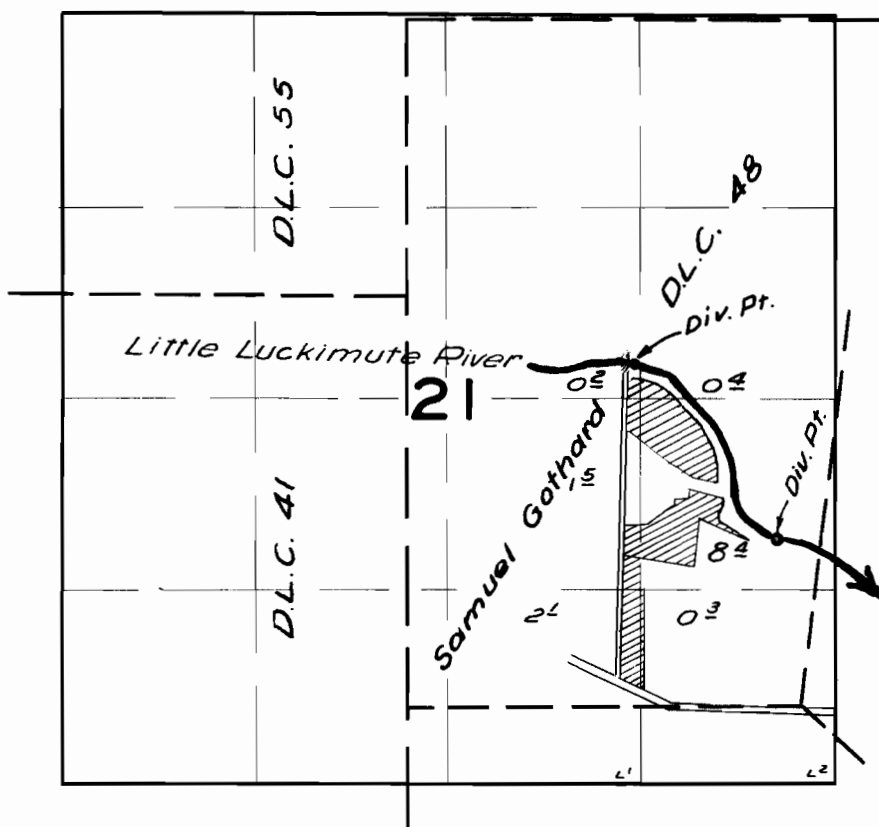

## FINAL PROOF SURVEY UNDER

Application No. 24260 Permit No. 19042  
IN NAME OF

*EARLE & HELEN L. SCHOONOVER*

Surveyed 24 Apr. 1958, by R. H. Whitby