


T.4S. R.1W.W.M.

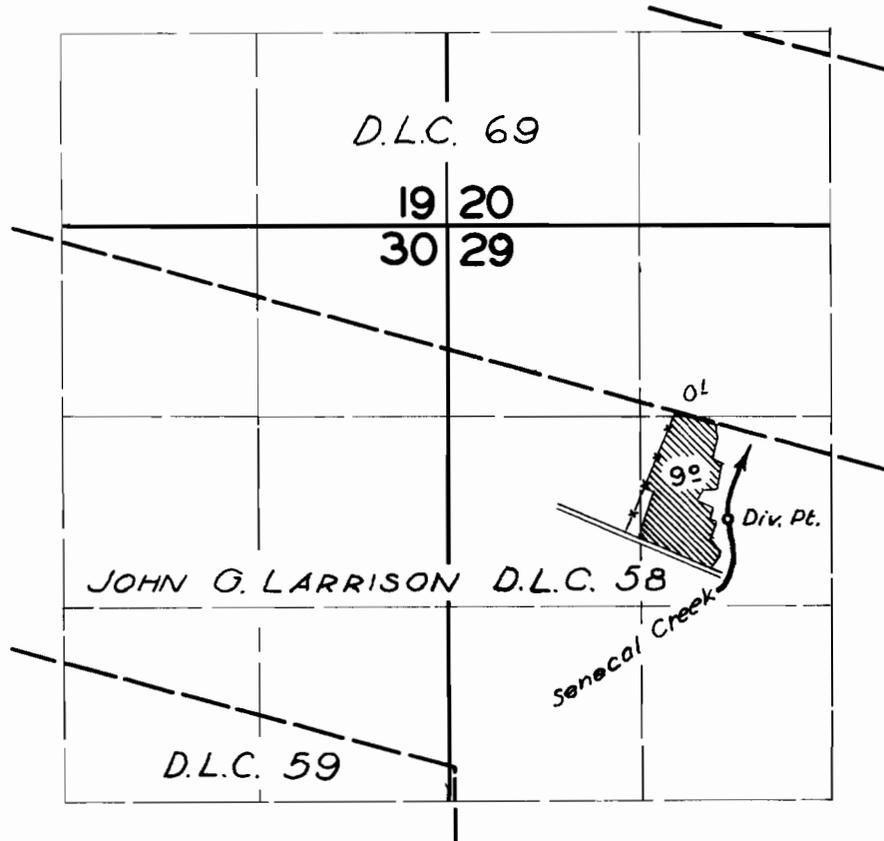

FINAL PROOF SURVEY
UNDER

Application No. 24265 Permit No. 19045
IN NAME OF

LEO V. OLSON

Surveyed 25 April 1958, by C.O. Bartels.