


T.39S.R.37E.W.M.

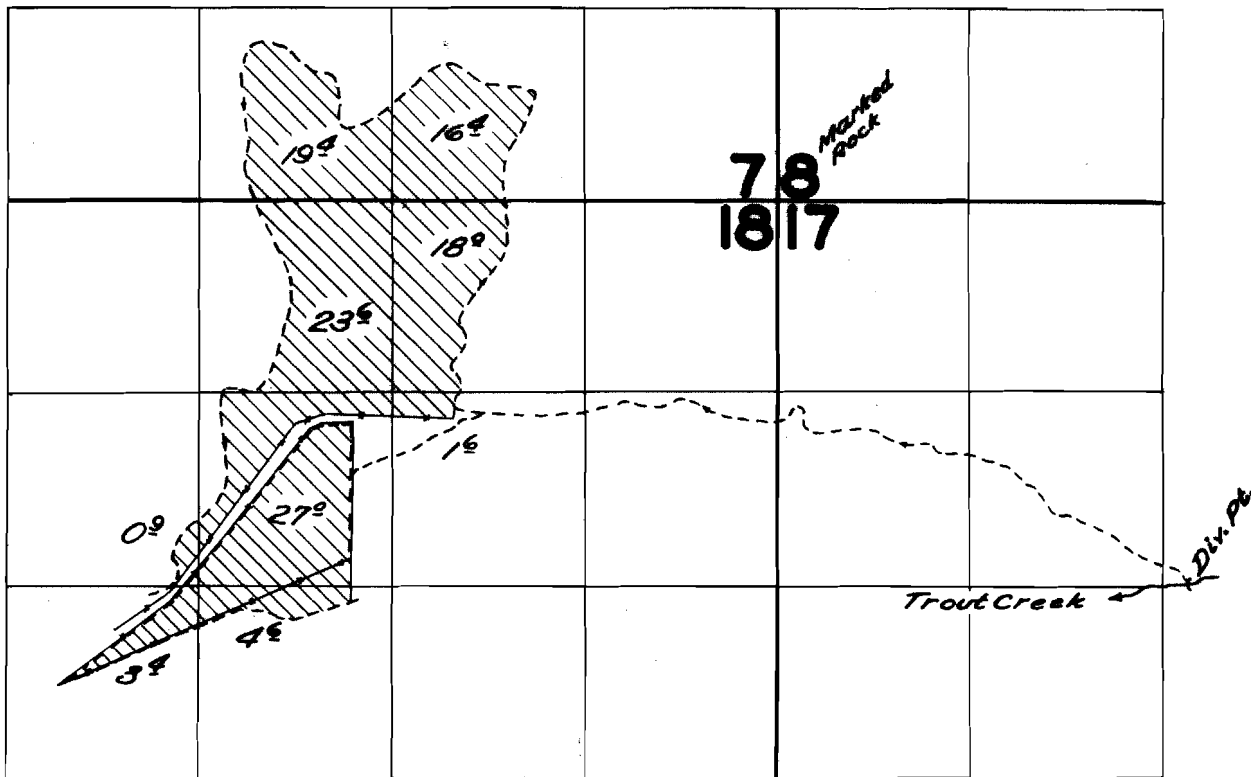

FINAL PROOF SURVEY UNDER

Application No. 24359 Permit No. 19141
IN NAME OF

James E. & Stella Calderwood

Surveyed July 26, 1958, by C.D. Smith