


T.8S. R.6W.W.M.

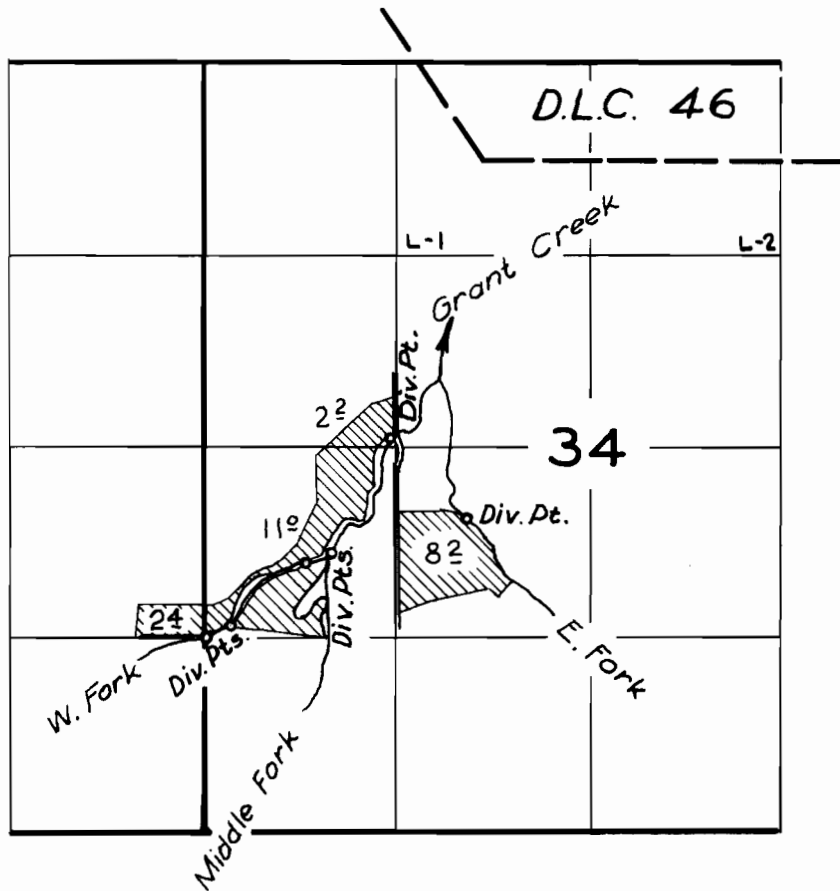

**FINAL PROOF SURVEY**  
UNDER

Application No. 24040 Permit No. 19194  
IN NAME OF

***KING BROTHERS***

Surveyed April 24, 1958, by R.H. Whitby