


T.28S.R.1 | W.W.M.

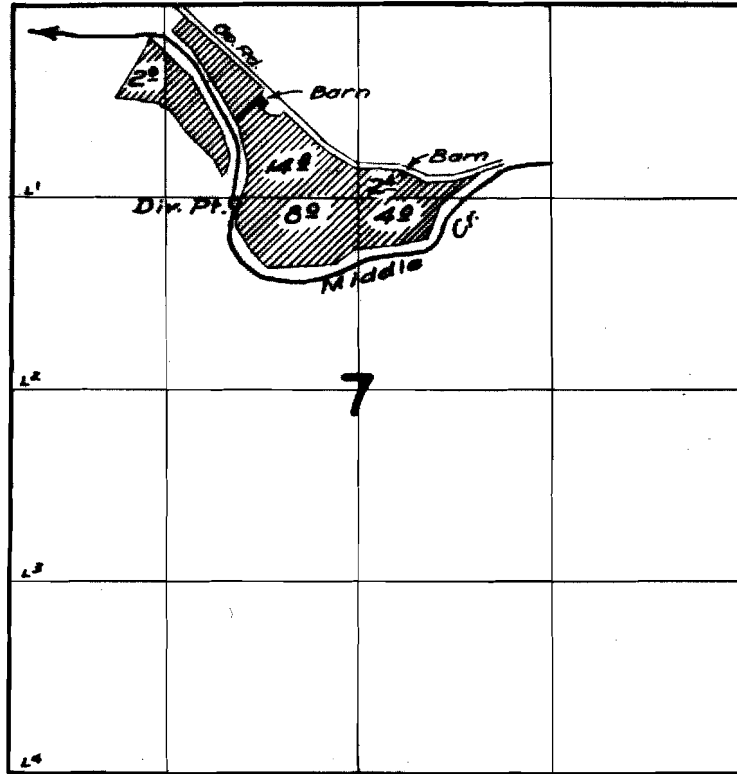

FINAL PROOF SURVEY
UNDER

Application No. 24437 Permit No. 19267
IN NAME OF

H.S. & Dorothy O. Krantz

Surveyed 27 May 1958, by Tr. Bish