


T.29S.R.14 W.W.M.

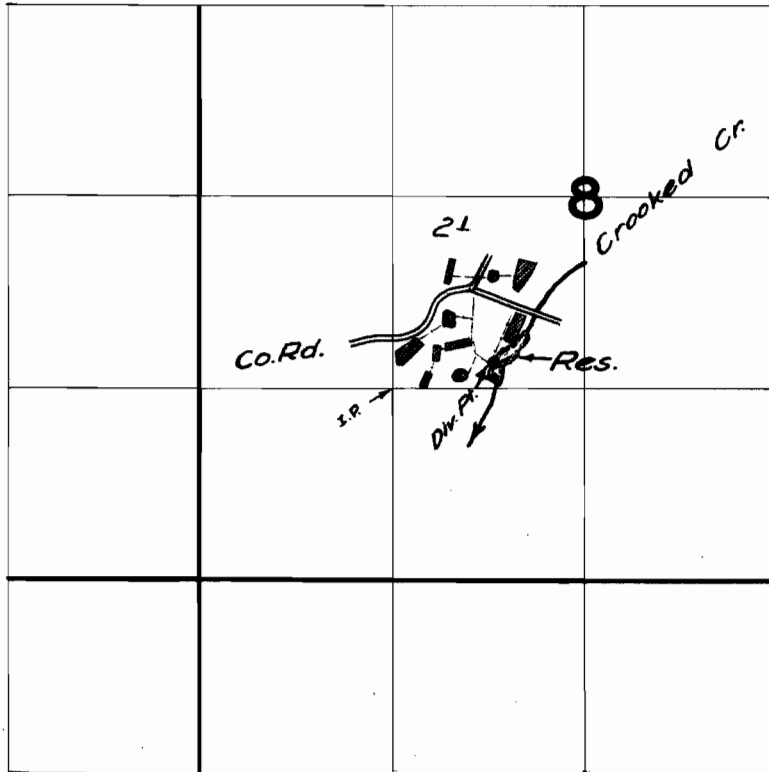

**FINAL PROOF SURVEY**  
UNDER

*R-23826*                      *R-1031*  
Application No. 23827 Permit No. 19433  
IN NAME OF

James E. Hawley

Surveyed April 19 1958, by Tm. Bush