


T.29S.R.14 W.W.M.

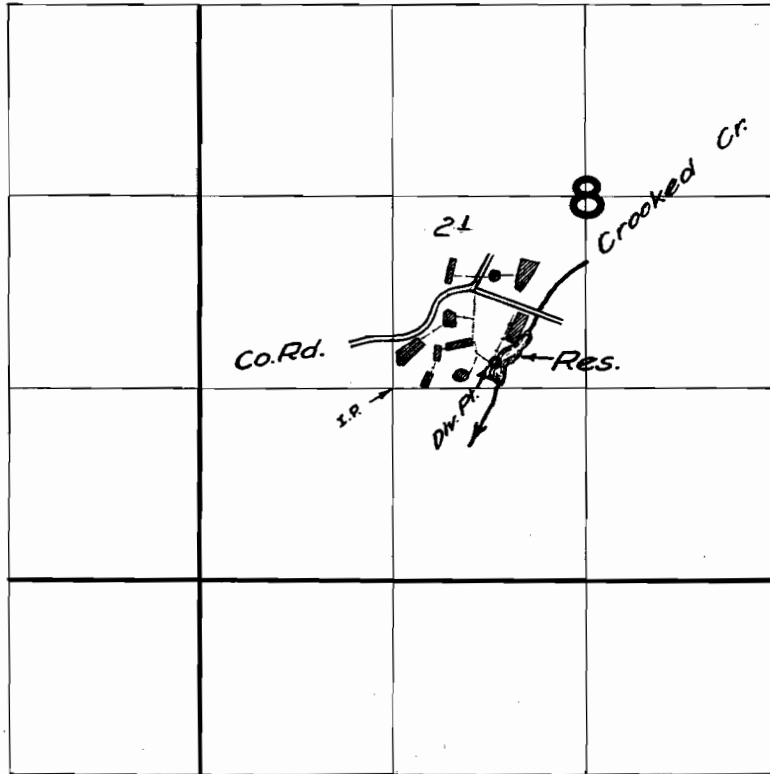

FINAL PROOF SURVEY
UNDER

R-23826 *R-1031*
Application No. *23827* Permit No. *19433*
IN NAME OF

James E. Hawley

Surveyed *April 19 1958*, by *M. B. Bish*