


T.8S. R.7 W.W.M.

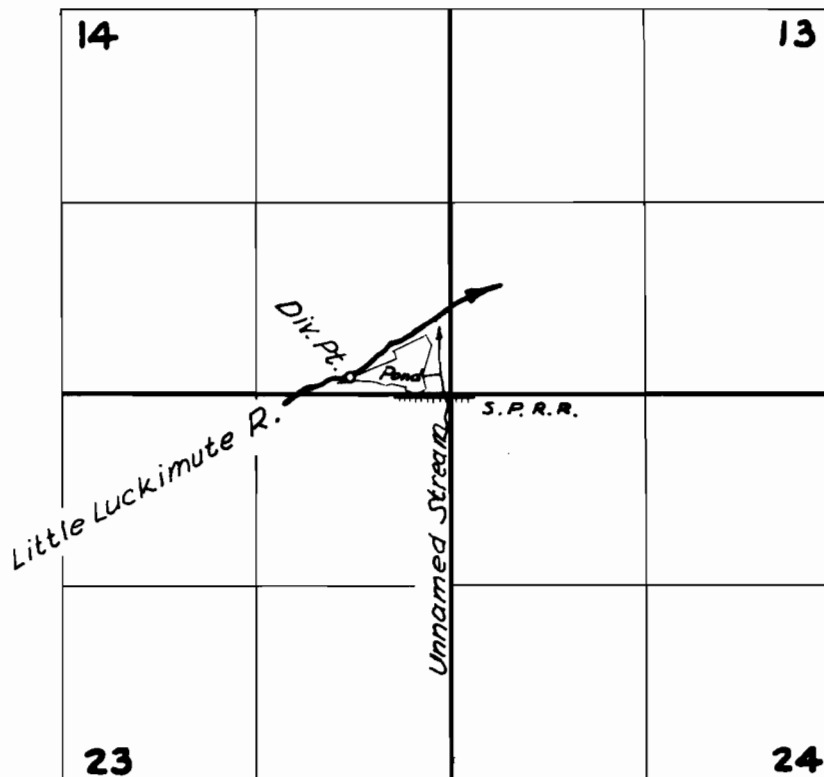

FINAL PROOF SURVEY
UNDER

Application No. 24156. Permit No. 19444
IN NAME OF

STEVENS EQUIPMENT CORP.

Surveyed April 25 1958, by R.H. Whitby