


T. 19 & 20 S. R. 34 E. W. M.

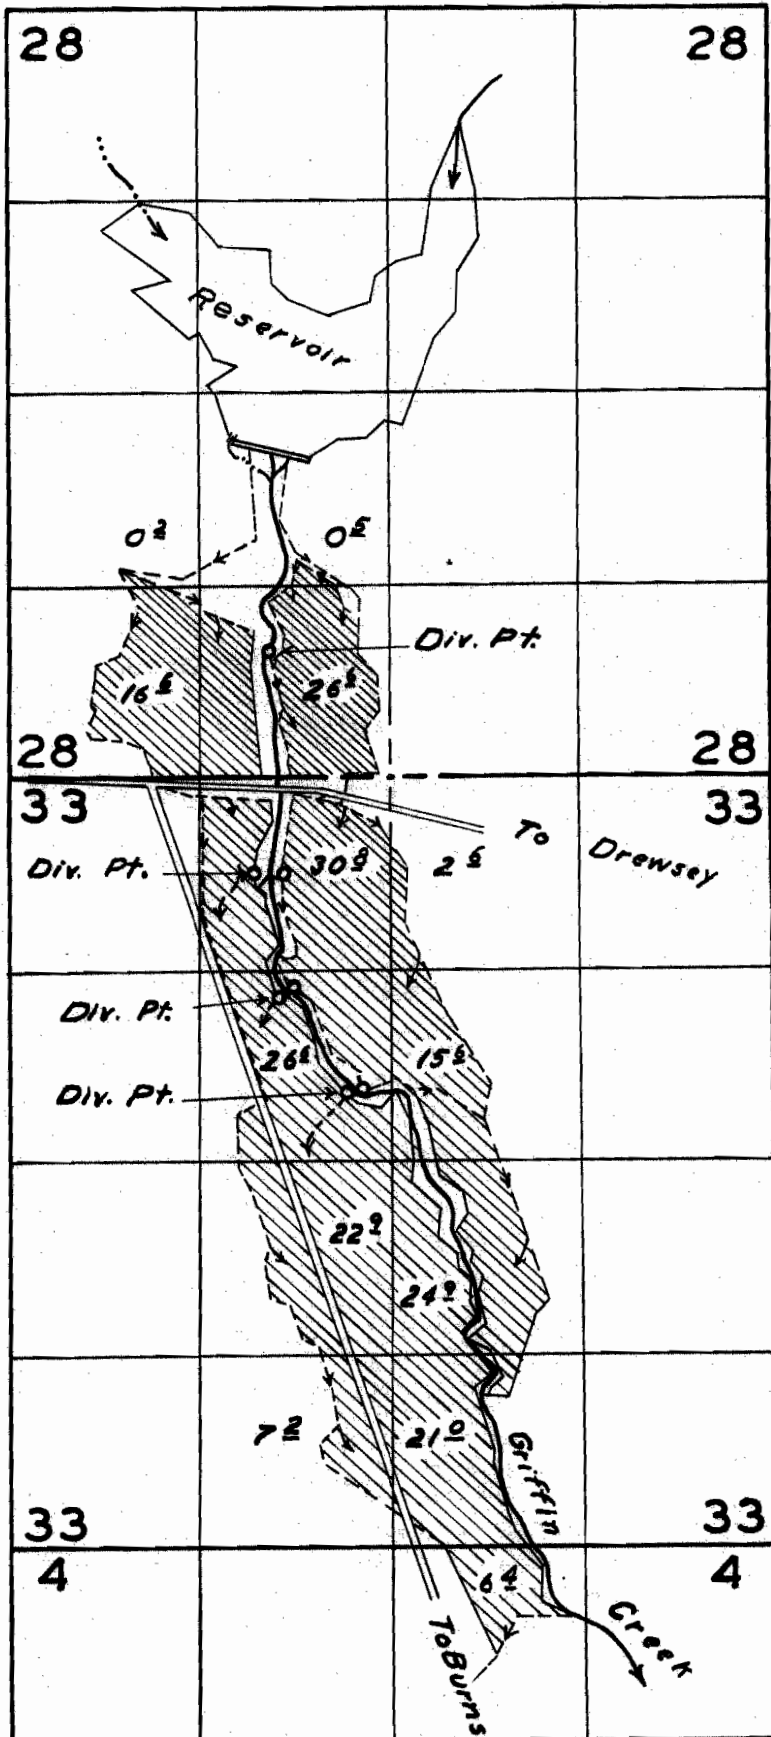

FINAL PROOF SURVEY  
UNDER

APPL. NO. ~~R 24925~~ 24926 PERMIT NO. R 1048  
R 26551 26552 19590  
R 1312  
21007

IN NAME OF  
JOEL C. SWORD  
SURVEYED AUG. 15, 17 1958 BY W. N. PERRY