


T. 19 & 20 S. R. 34 E. W. M.

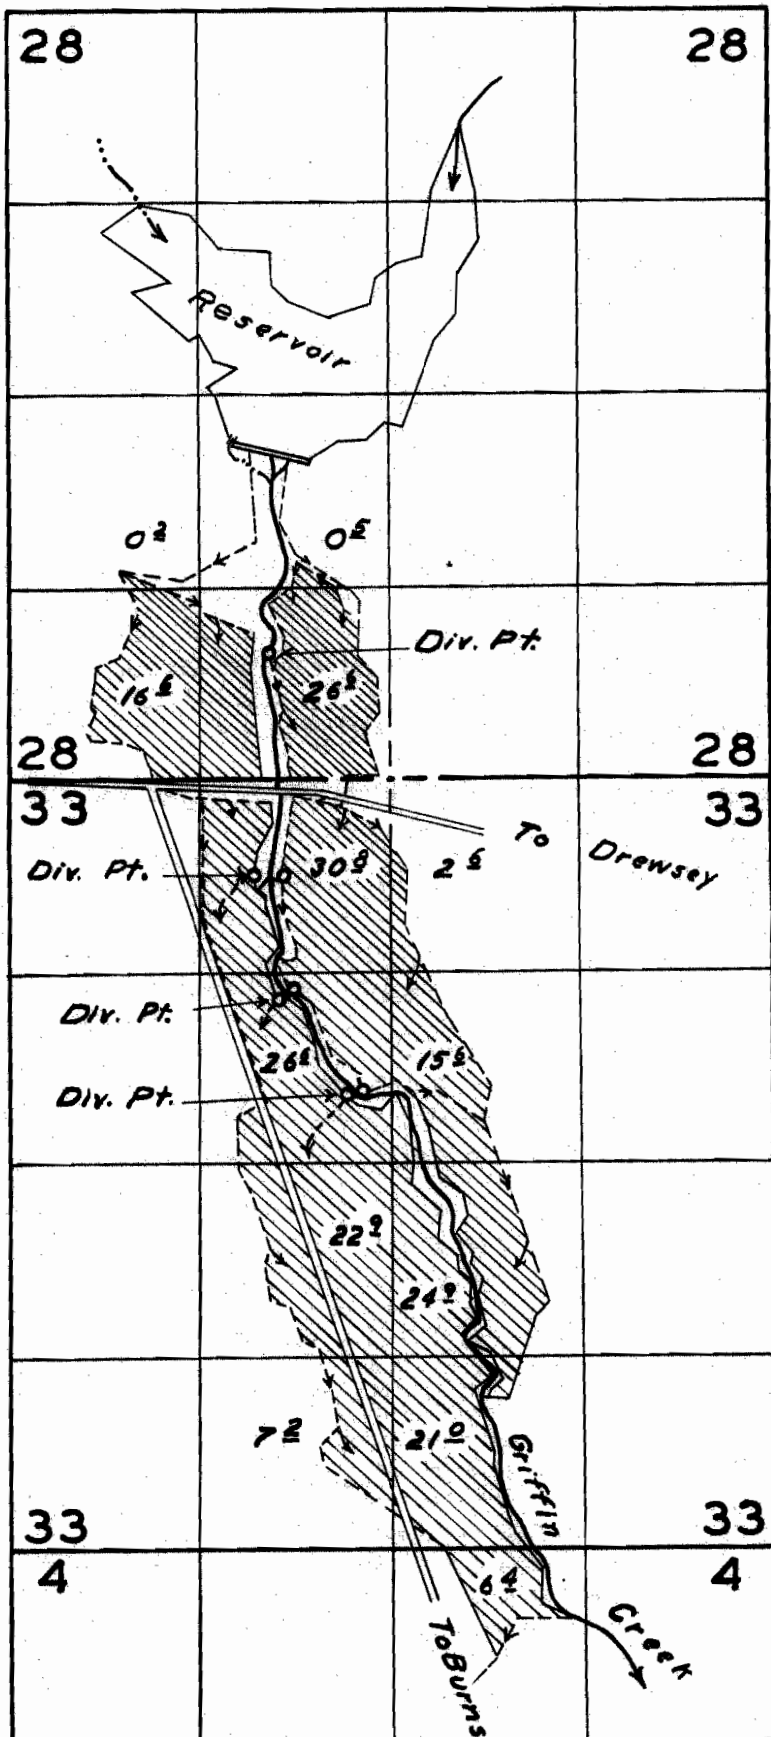

FINAL PROOF SURVEY
UNDER

APPL. NO. ~~R 24925~~ 24926 PERMIT NO. R 1048
~~R 26551~~ 26552 19590
21007

IN NAME OF
JOEL C. SWORD
SURVEYED AUG. 15, 17 1958 BY W. N. PERRY