


T.8S. R.6 W.W.M.

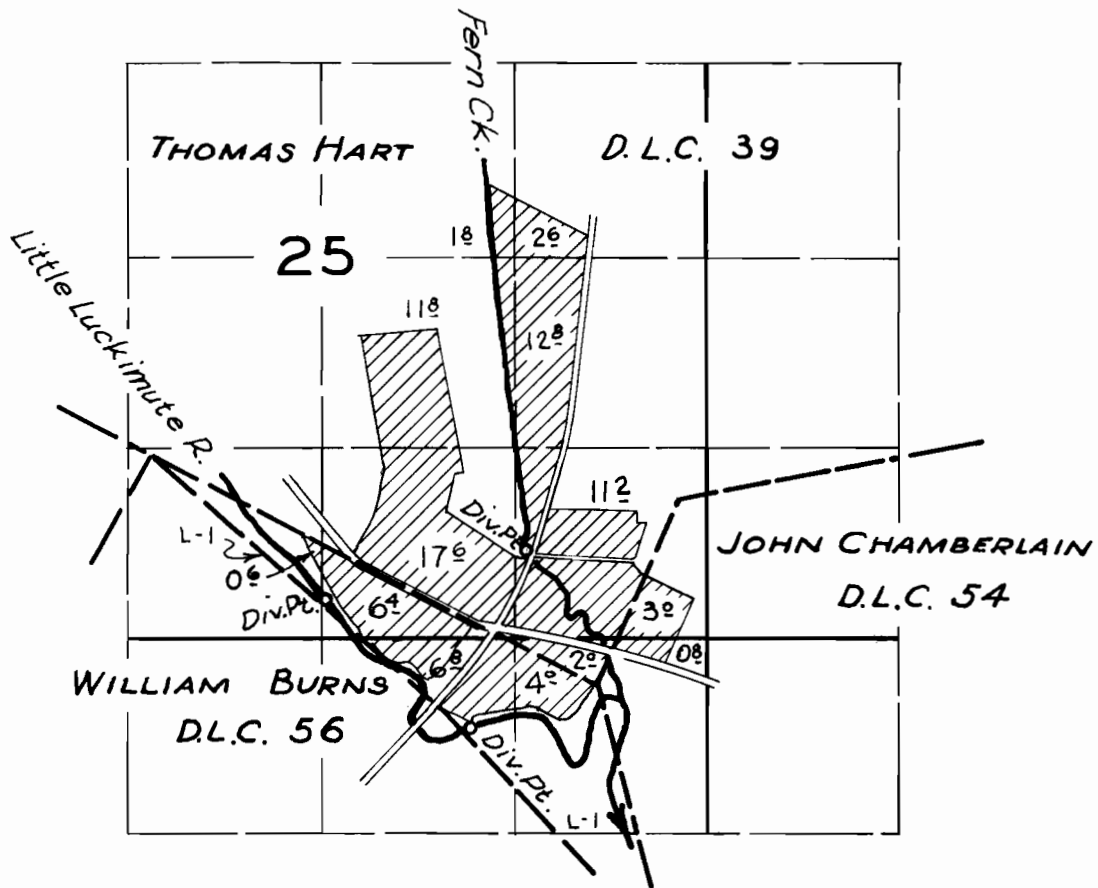

FINAL PROOF SURVEY
UNDER

Application No. 24569. Permit No. 19648
IN NAME OF

ELLIS H. BREEDEN

Surveyed May 13 1958, by R.H. Whitby