


T. 3 S. 2 W. W. M.

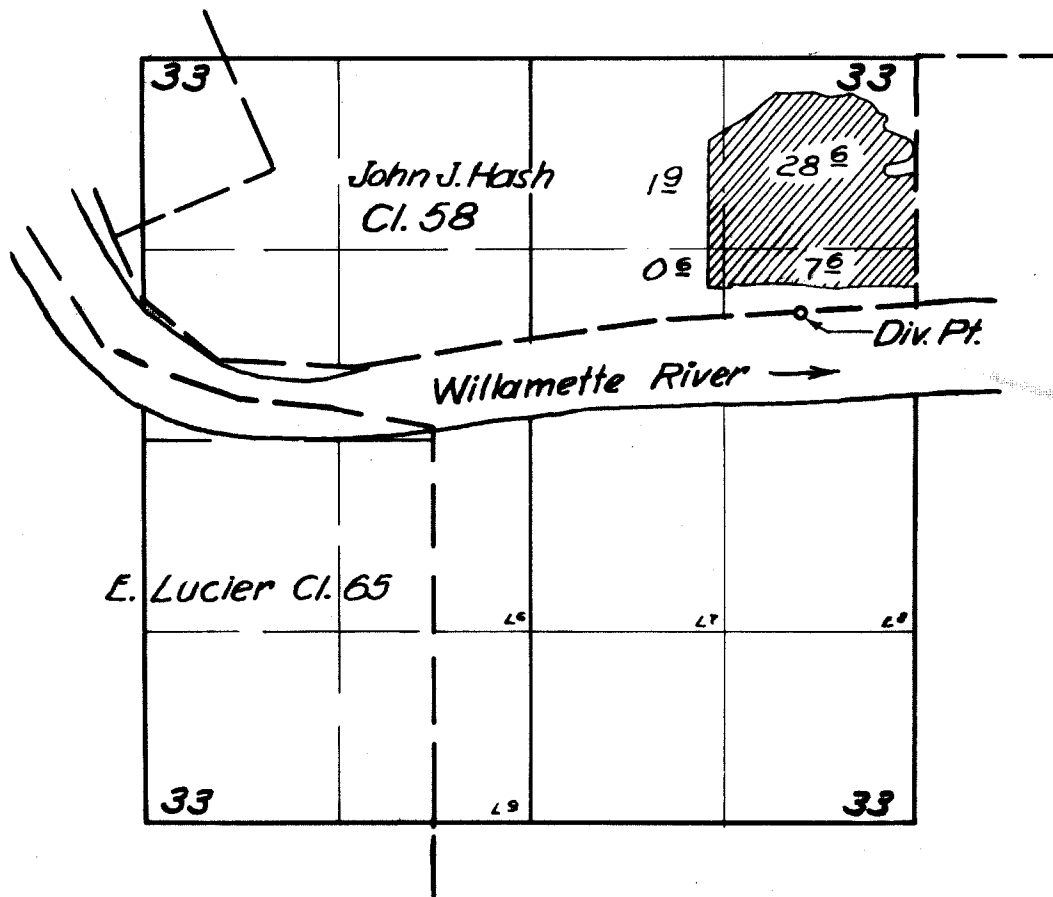

FINAL PROOF SURVEY
UNDER

Application No. 24788 Permit No. 19670
IN NAME OF

Wilmot C. Foster

Surveyed Mar. 19 1955, by Tom Bish