


T. 10S. R. 2W. W.M.

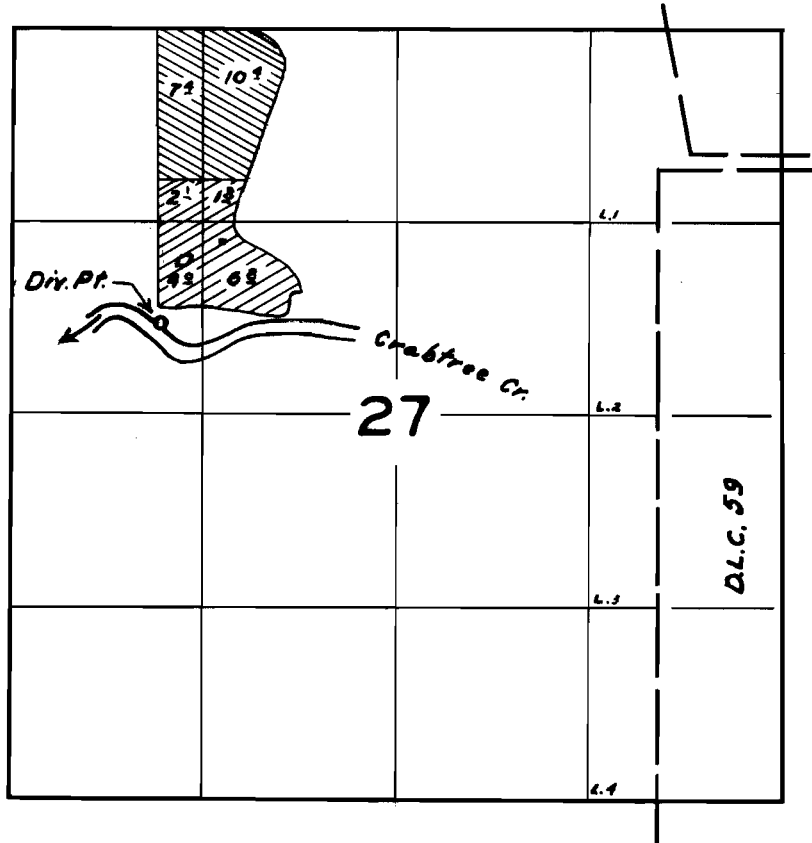

FINAL PROOF SURVEY
UNDER

Application No. ²⁵³³¹~~26291~~ Permit No. ¹⁹⁸⁷⁴21200
IN NAME OF

Ralph & Klara Renkert
Mar. 19, 1957 M. Bish
Surveyed Sept. 9, 1958, by W. N. Perry