


T. 9 S. R. 5 & 6 W. W. M.

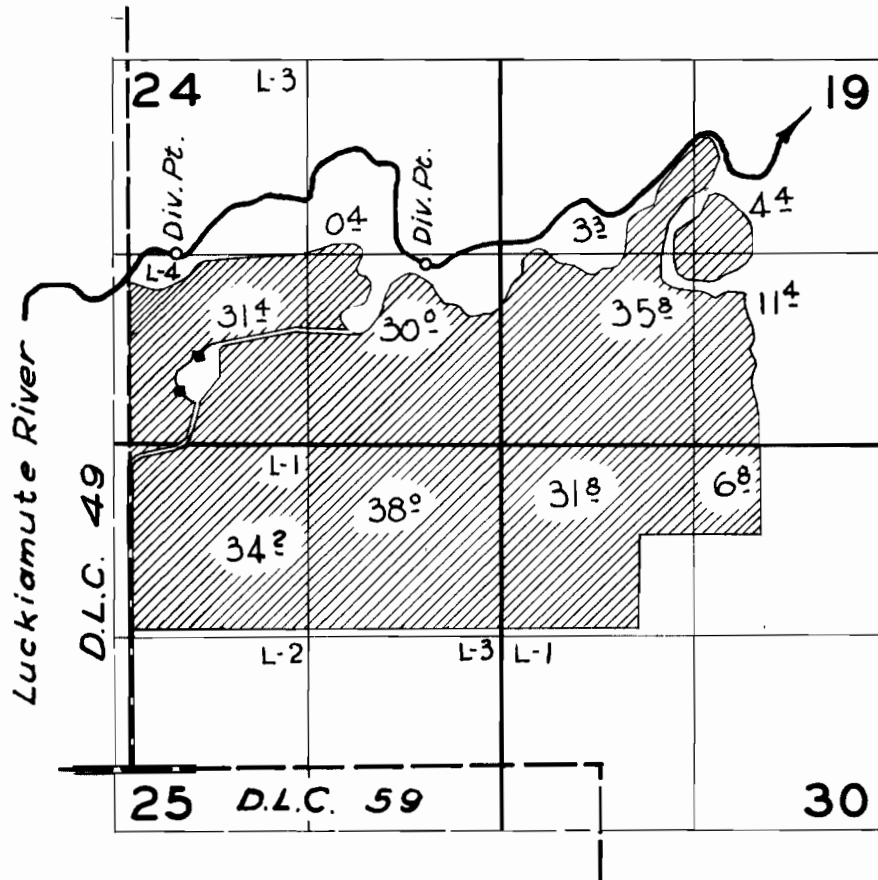

**FINAL PROOF SURVEY**  
UNDER

Application No. 25428 Permit No. 19903  
IN NAME OF

*V.L. MATHANY*

Surveyed May 15 1958, by R.H. Whitby