


T.9S. R.3E.W.M.

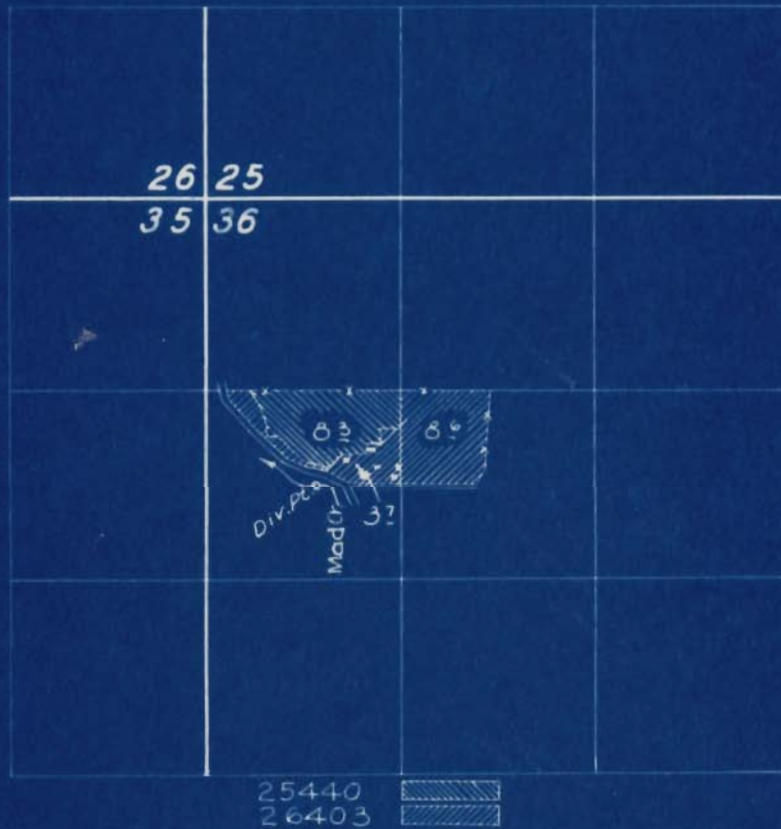

**FINAL PROOF SURVEY**

UNDER

Application No. 25440 Permit No. 20009  
26403 20713  
IN NAME OF

**CHARLES C. & LUCILLE H. TUCKER**

Surveyed 16 July 1958, by C.O. Bartels