


T.IIS. R. | W. W. M.

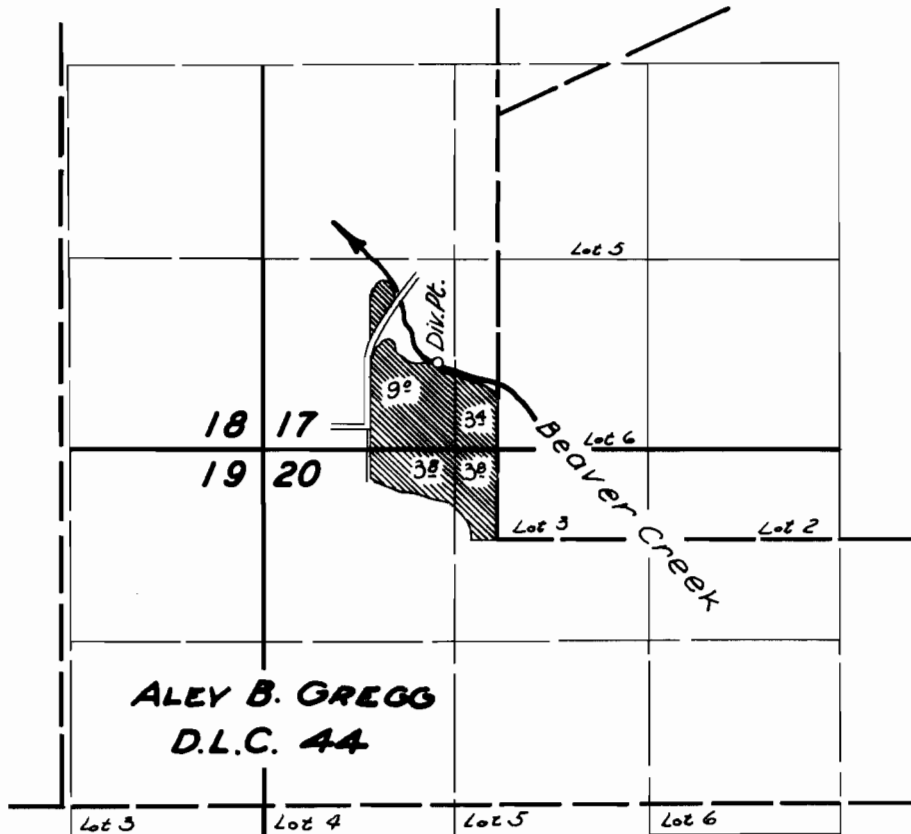

**FINAL PROOF SURVEY**  
UNDER

Application No. 25491. Permit No. 20031.  
IN NAME OF

**GALE G. WERNER**

Surveyed 12 Sept. 1958, by C.O. Bartels