




T.10S. R.7 W.W.M.

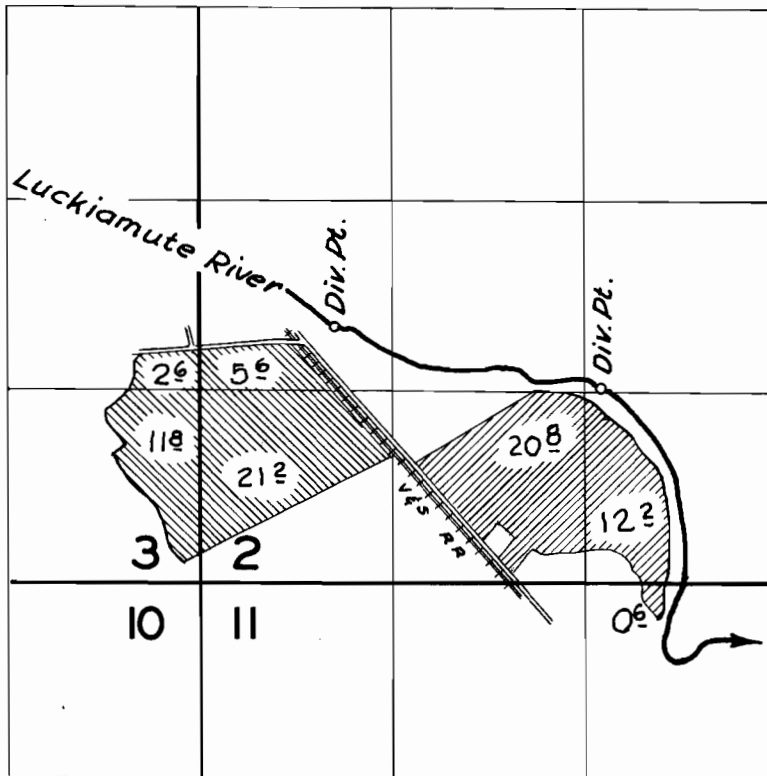

25761 
28477 

FINAL PROOF SURVEY
UNDER

25761 20268
Application No. 28477 Permit No. 22302
IN NAME OF

H. E. BARNHART & FRANK KOCHS

Surveyed 21 May 1958, by R.H. Whitby