


T.IIS. R.I.W.W.M.

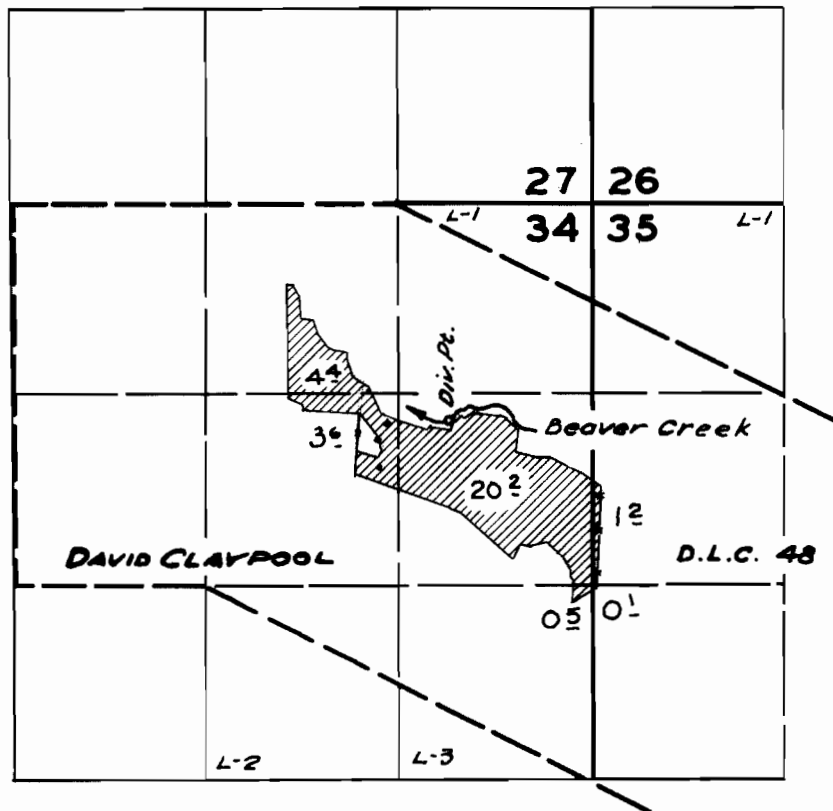

FINAL PROOF SURVEY
UNDER

Application No. 25988... Permit No. 20363.
IN NAME OF

FRANK D. & ELTA E. BAIN

Surveyed 8 July, 1958, by C.O. Bartels...