


T.10S. R.6 W.W.M.

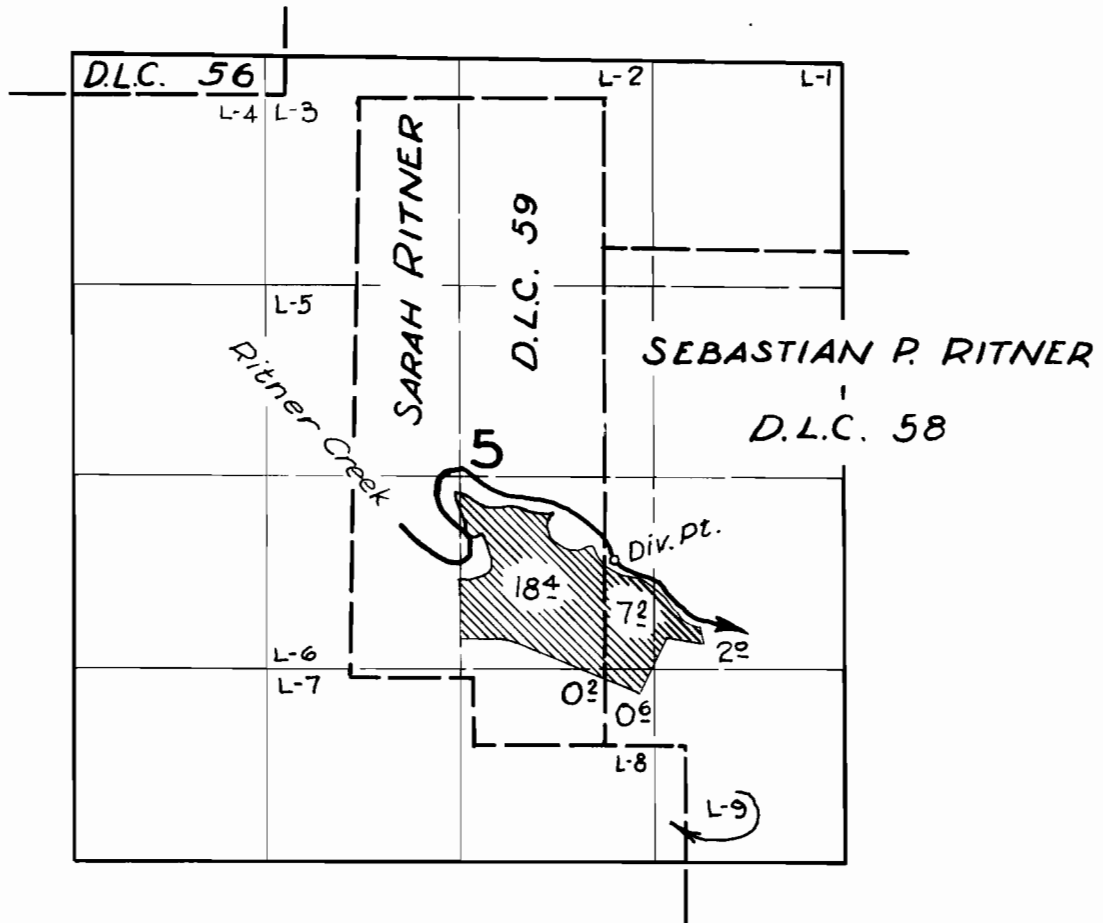

FINAL PROOF SURVEY
UNDER

Application No. 24542 Permit No. 20477
IN NAME OF

OTTO G. EDWARDS

Surveyed 23 May 1958, by R.H. Whitby