


T. 1 N., R. 2 W., W. M.

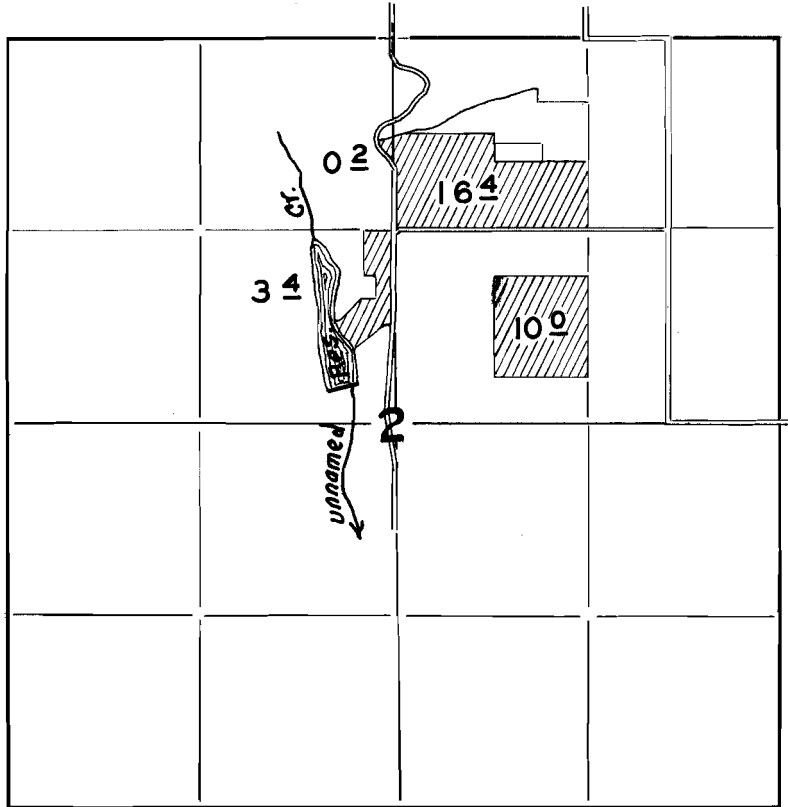

FINAL PROOF SURVEY

UNDER

R-25875

R-1211

Application No. ~~25875~~ 25876 Permit No. 20532

IN NAME OF

WILHELM & ROSA MULLERLEILE

Surveyed 4 - 10 1956, by M. BISH.....