


T. 10S. R. 6W.W.M.

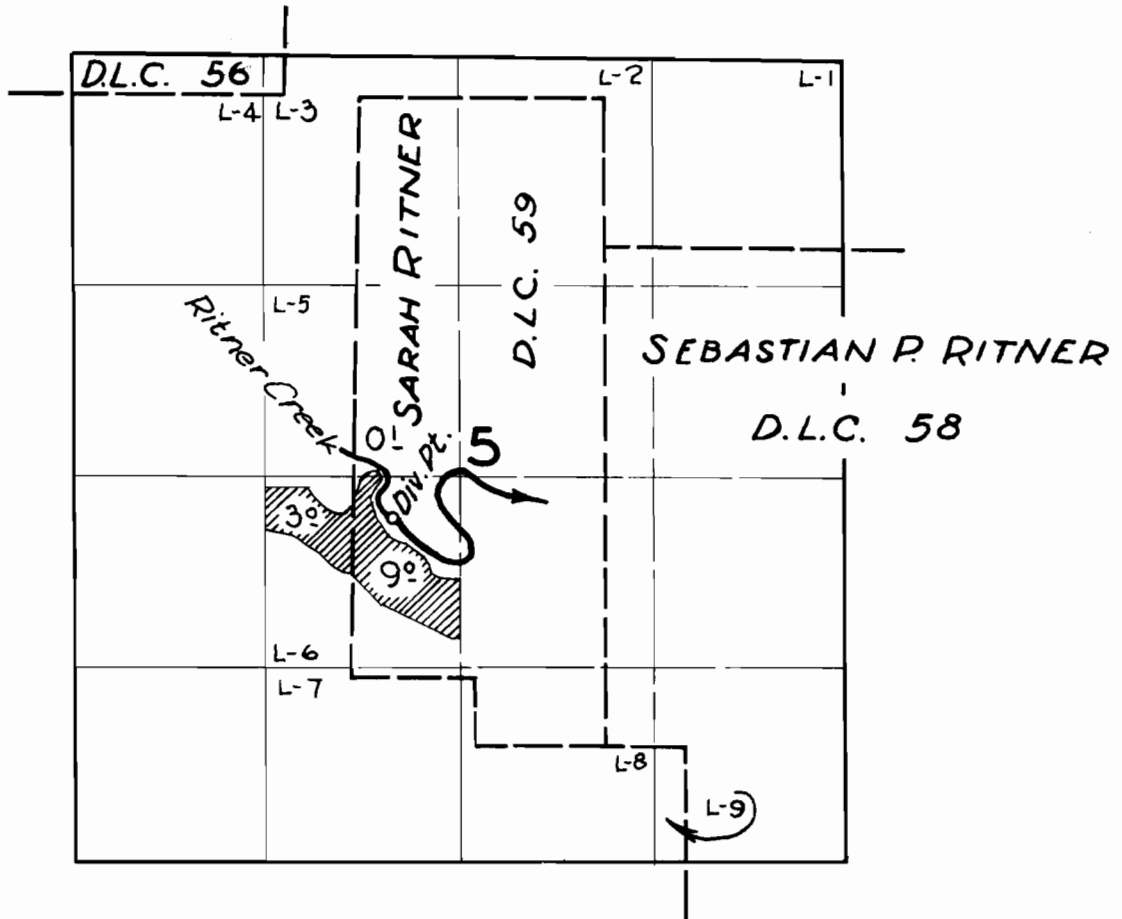

FINAL PROOF SURVEY
UNDER

Application No. 26499 Permit No. 20767
IN NAME OF

RITTIE KERBER

Surveyed 23 May 1958, by R.H. Whitby