


T.7S.R.5W.W.M.

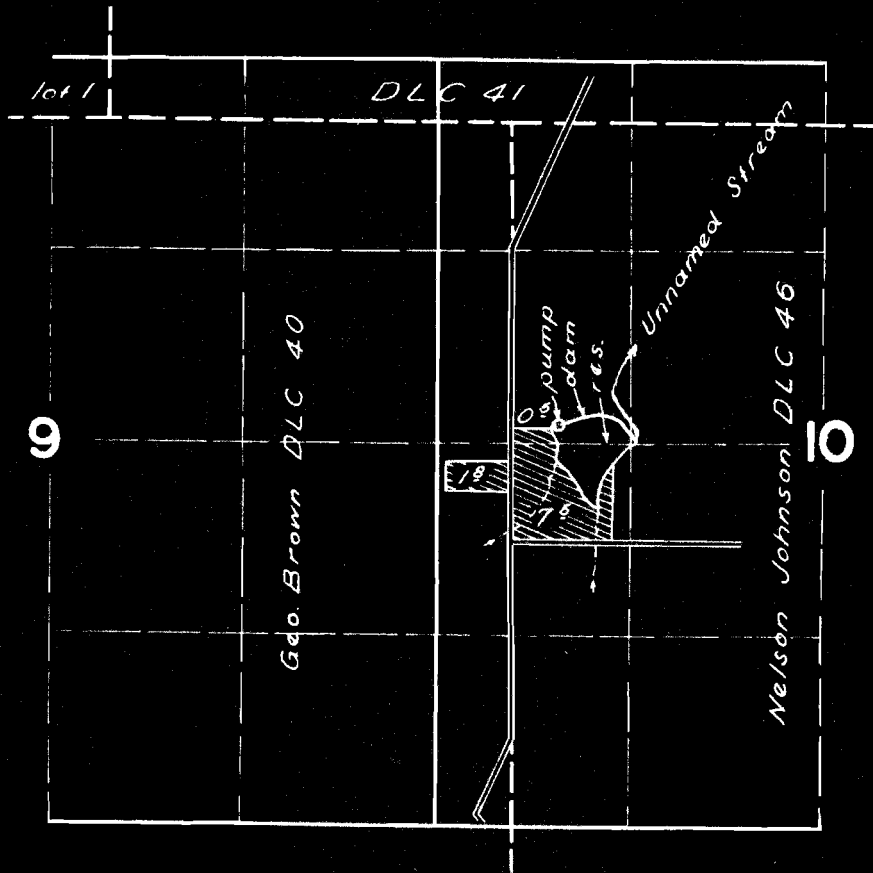

FINAL PROOF SURVEY
UNDER

R-26519 R-1266
Application No. 26520 Permit No. 20785
IN NAME OF

FRANK A. WALL

Surveyed 24 July 1957, by *[Signature]*