


T. 9S. R. 4 W. W.M.

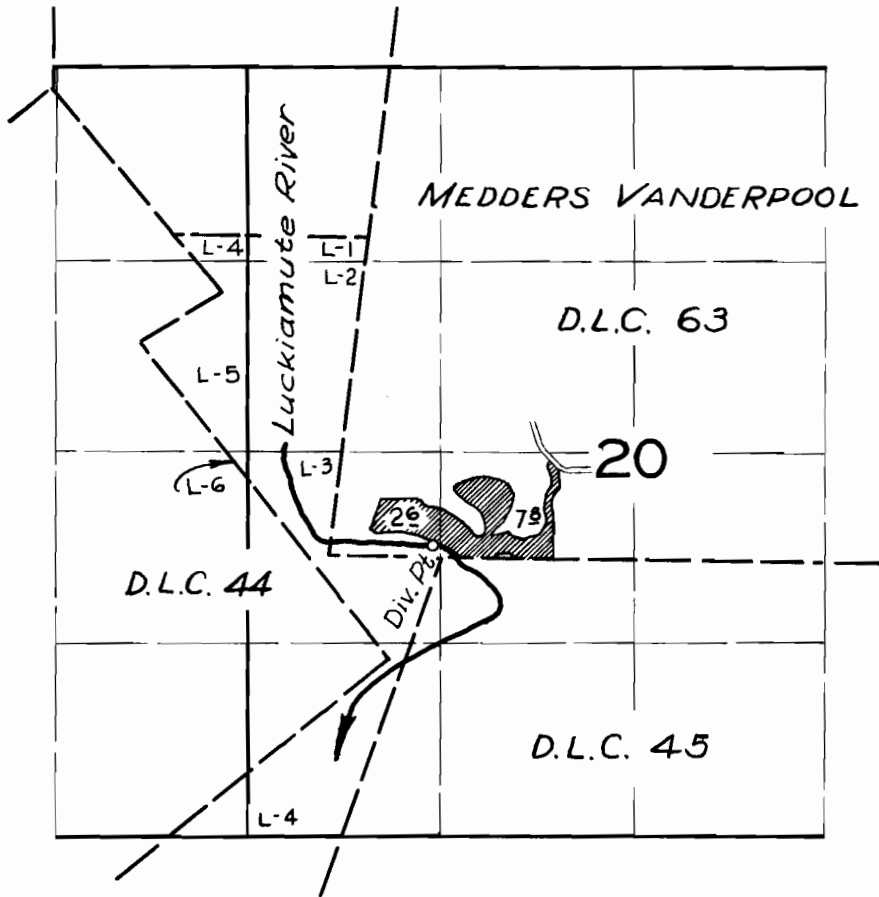

FINAL PROOF SURVEY
UNDER

Application No. 26593... Permit No. 20830.
IN NAME OF

JOHN L. SPARKS

Surveyed May 20 1958, by R.H. Whitby.