


T.13 S. R.1 W.W.M.

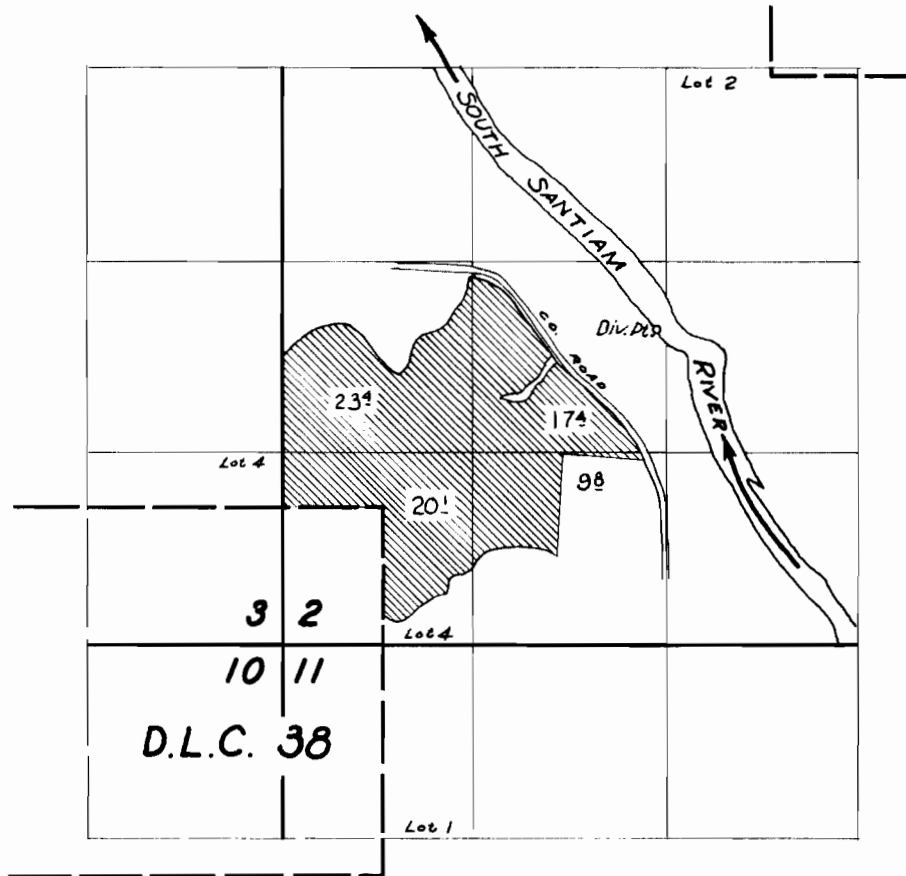

**FINAL PROOF SURVEY**  
UNDER

Application No. 26705 . Permit No. 20904 .  
IN NAME OF

***GEORGE & MARTHA FRITZ***

Surveyed 5 SEPT. 1958 , by C.O. Bartels.