


T. 3S. R. 4E. W.M.

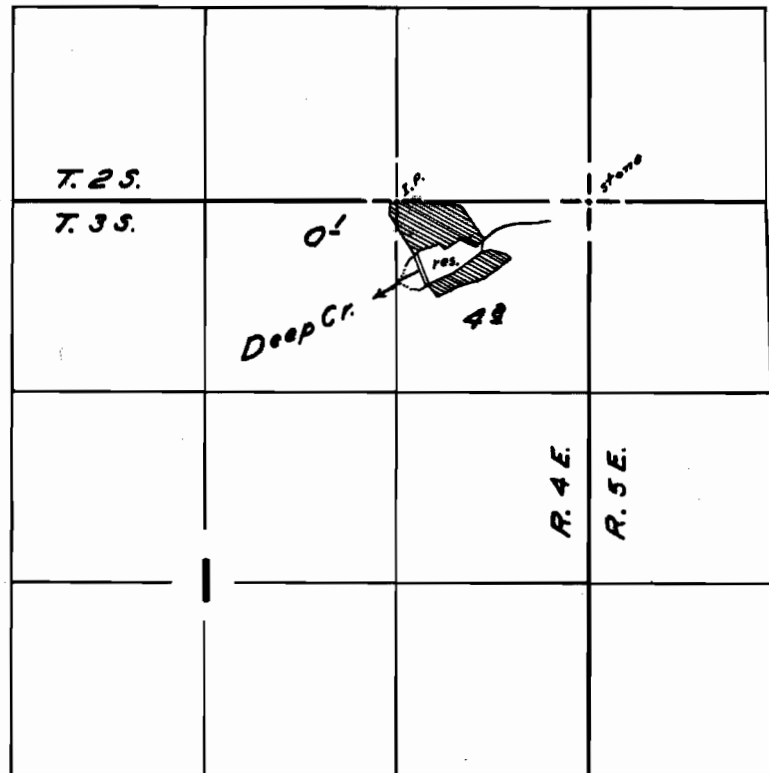

FINAL PROOF SURVEY
UNDER

26760 20934
R30020 R-1727
Application No. 30021 Permit No. 23477
IN NAME OF

Oliver Burglund

Surveyed Oct. 1, 1958, by W.N. Perry