


T. 4S. R. 4E. W.M.

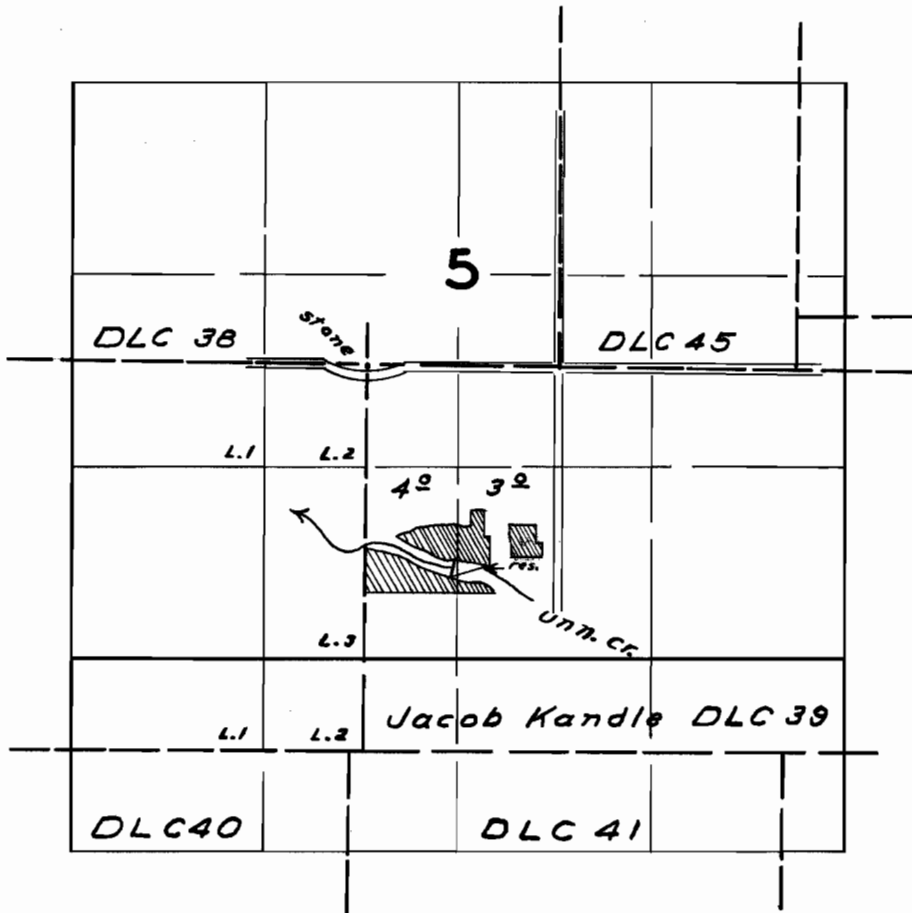

FINAL PROOF SURVEY
UNDER

R-26637 R-1315
Application No. 26366 Permit No. 20997
IN NAME OF

Joseph Guttridge

Surveyed *Oct. 10 1958*, by *W. N. Perry*