


T.30 S.R.2 W.W.M.

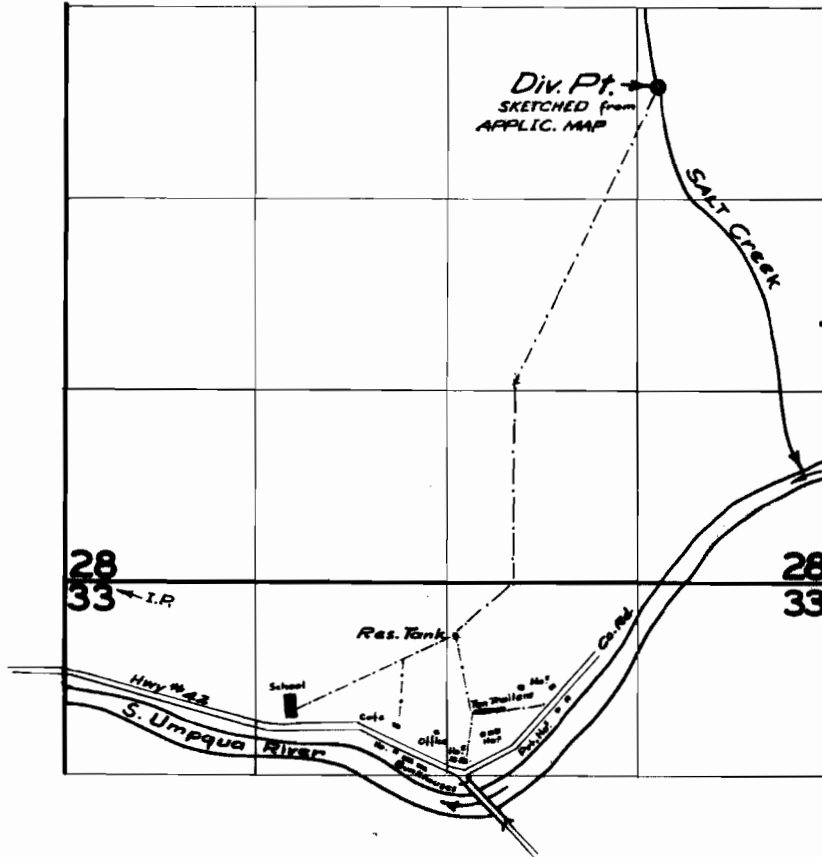

FINAL PROOF SURVEY UNDER

Application No. 26882 Permit No. 21105
IN NAME OF

Cooper & Young

Surveyed Sept. 9 1959, by *M. B. Bish*