


T. 2S. R. 2E. W. M.

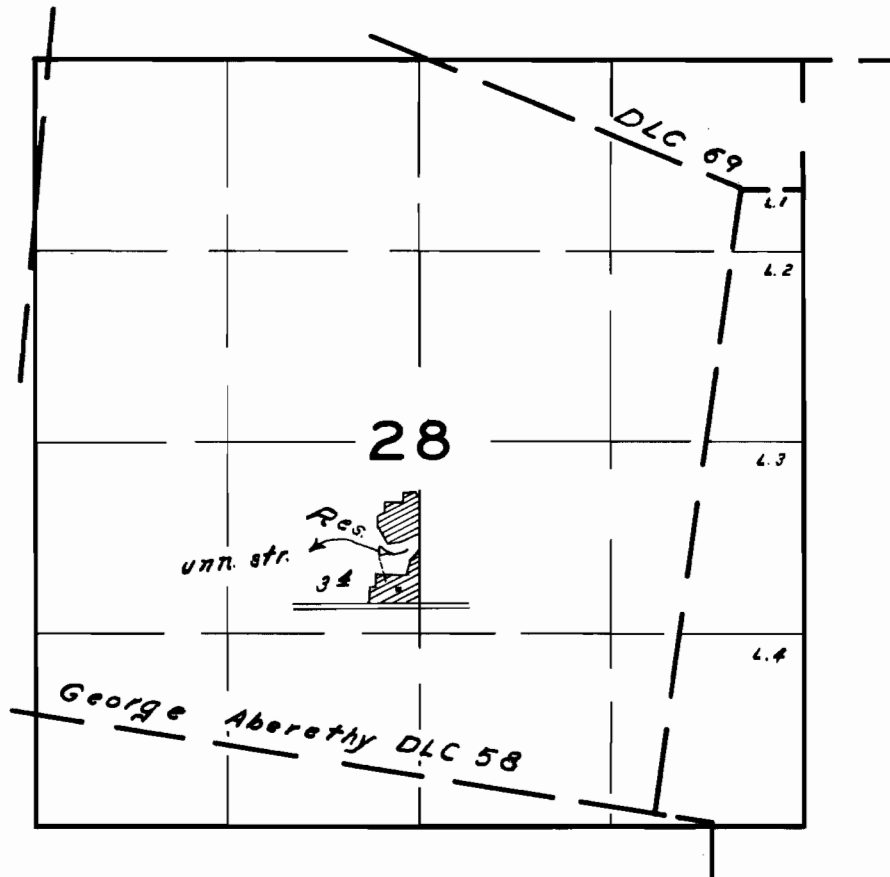

FINAL PROOF SURVEY
UNDER

Application No. R-26917 Permit No. R-1336
26918 21151
IN NAME OF

Thomas F. & Viola E. Fender

Surveyed July 7 1958, by W. N. Perry