


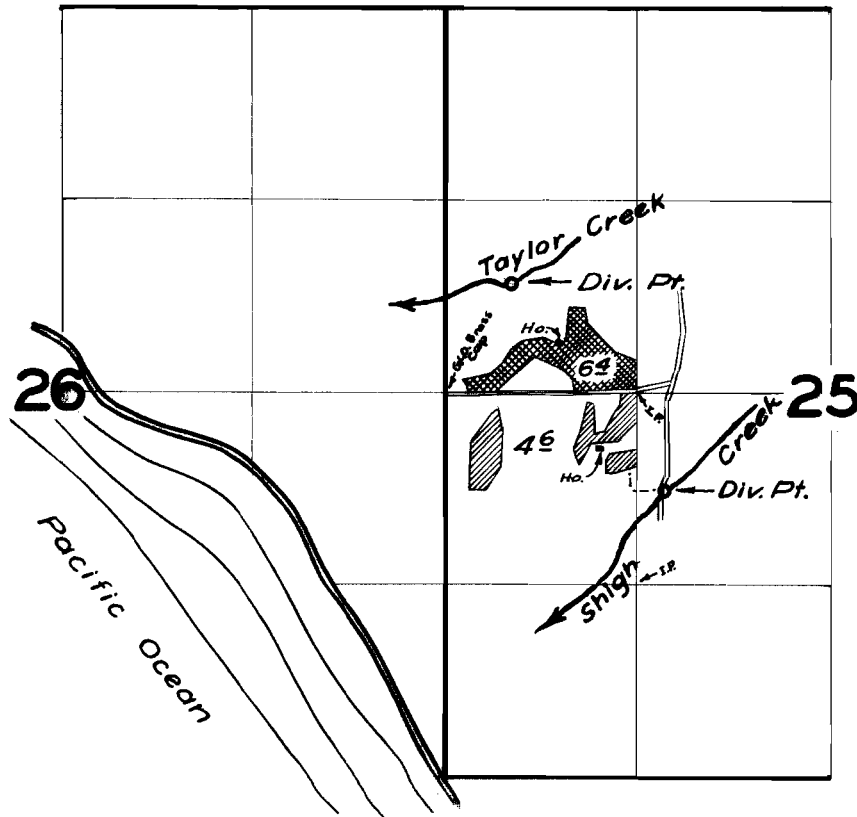

T.40S.R.14W.W.M.



**FINAL PROOF SURVEY**  
UNDER

Application No. 26945 Permit No. 21170   
Application No. 26946 Permit No. 21171   
IN NAME OF

Carl L. Johnson

Surveyed 24 Mar 1958 by Tr. Bish