


T.40S.R.14W.M.

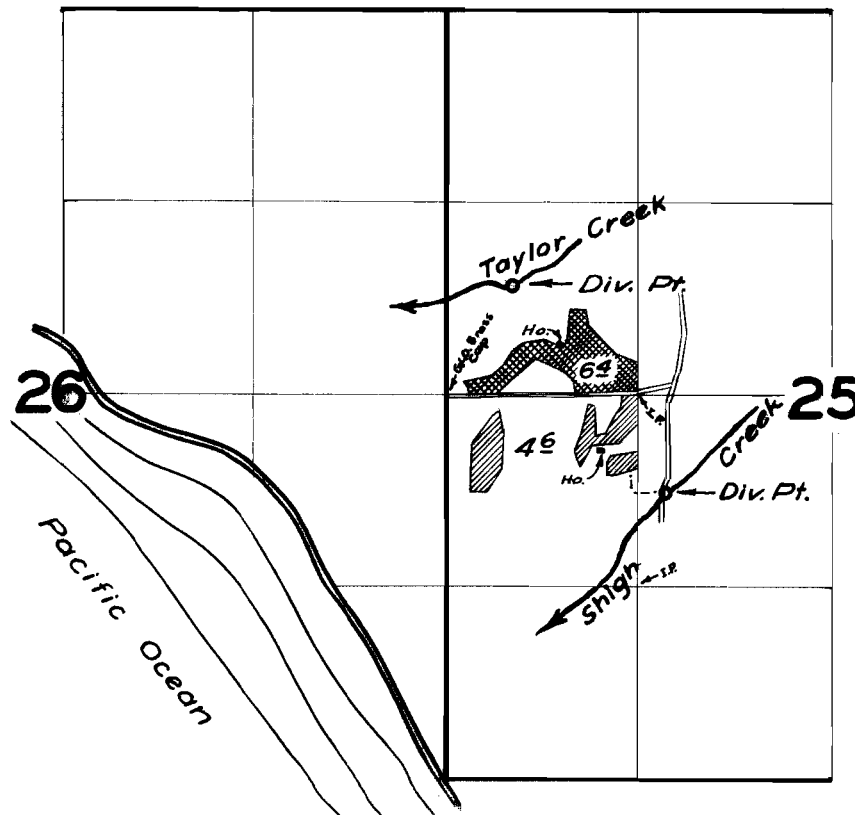

FINAL PROOF SURVEY
UNDER

Application No. ²⁶⁹⁴⁵~~26946~~ Permit No. ²¹¹⁷⁰~~21171~~ 
IN NAME OF

Carl L. Johnson

Surveyed 24 Mar 1958 by M. Bish