


T.5 S.R.6 W.W.M.

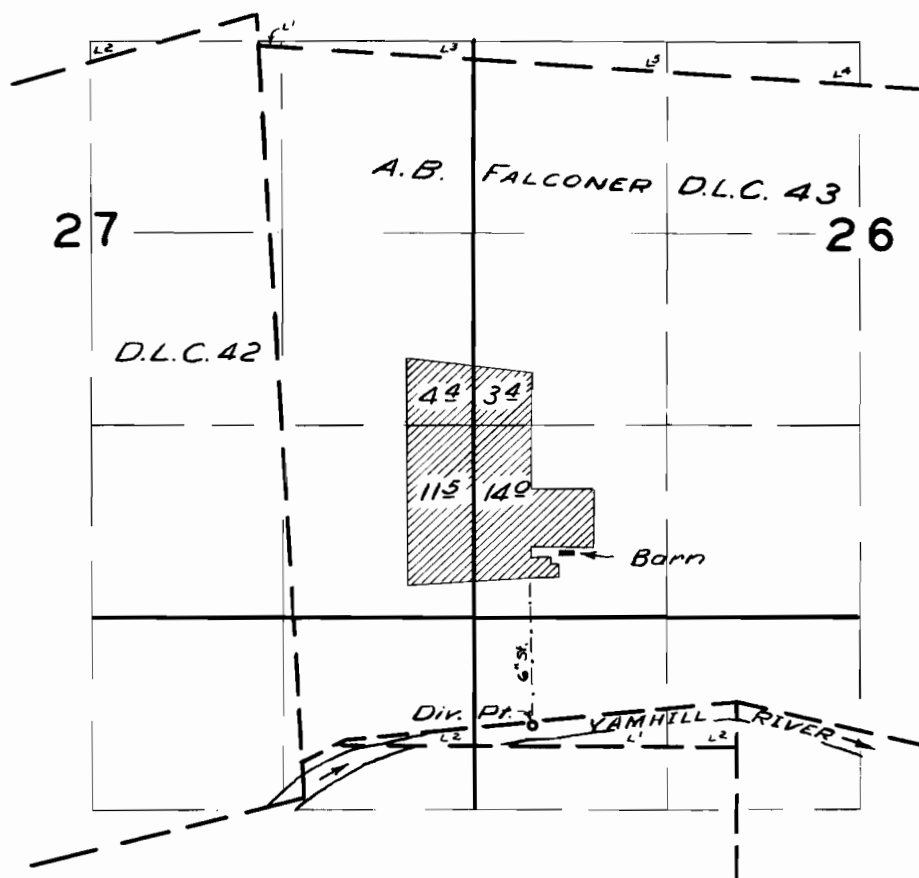

FINAL PROOF SURVEY UNDER

Application No. 27228.. Permit No. 21422..
IN NAME OF

.....FRANK STUCK.....

Surveyed 10 April 1958, by M. B. B. B.