


T.13S. R.1E.W.M.

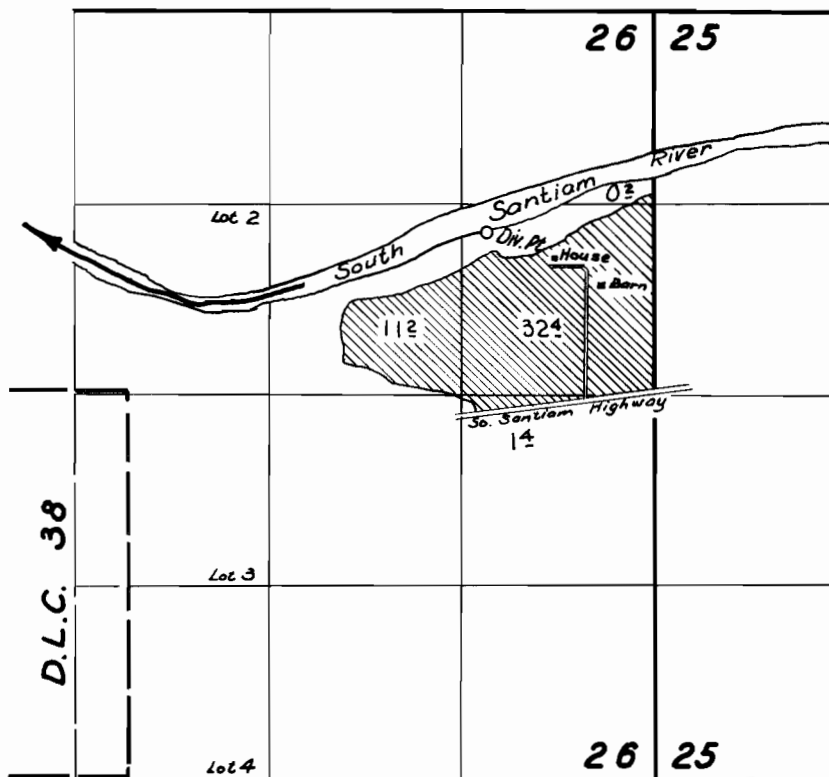

**FINAL PROOF SURVEY**  
UNDER

Application No. 27332. Permit No. 21489...  
IN NAME OF

**ARNOLD K. & MARGARET L. HARRANG**

Surveyed 5. Sept. 1958, by C.O. Bartels