


T. 2S. R. 2E. W.M.

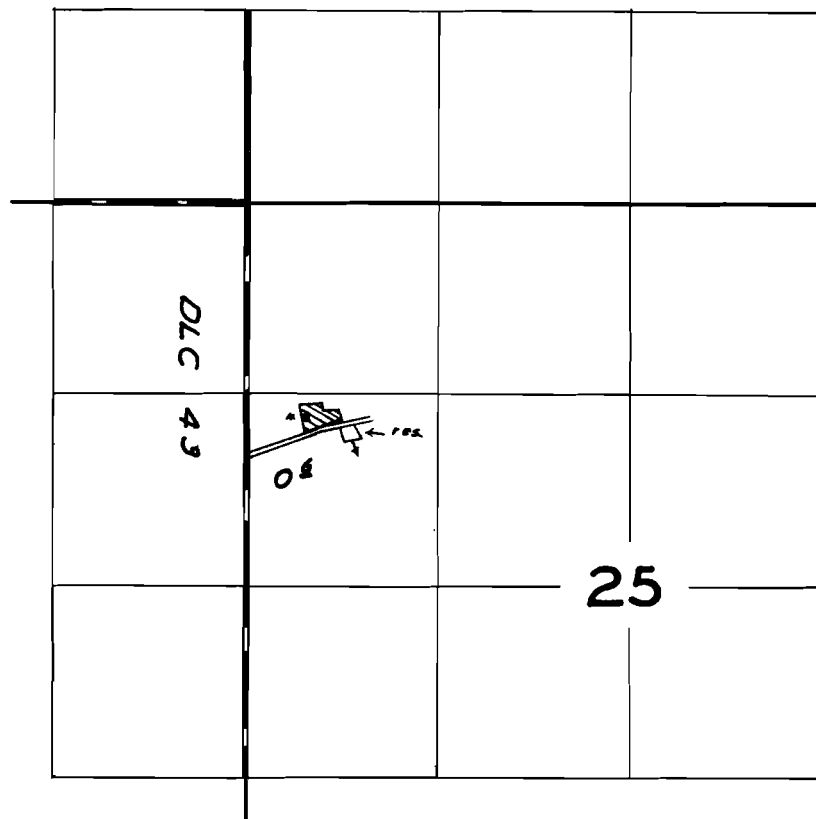

FINAL PROOF SURVEY
UNDER

Application No. 27481 Permit No. 21492
R-27275 R-1367
IN NAME OF

Richard B. Hemmingsen

Surveyed July 30 1958, by W.N. Perry