


T.9S. R.6W.W.M.

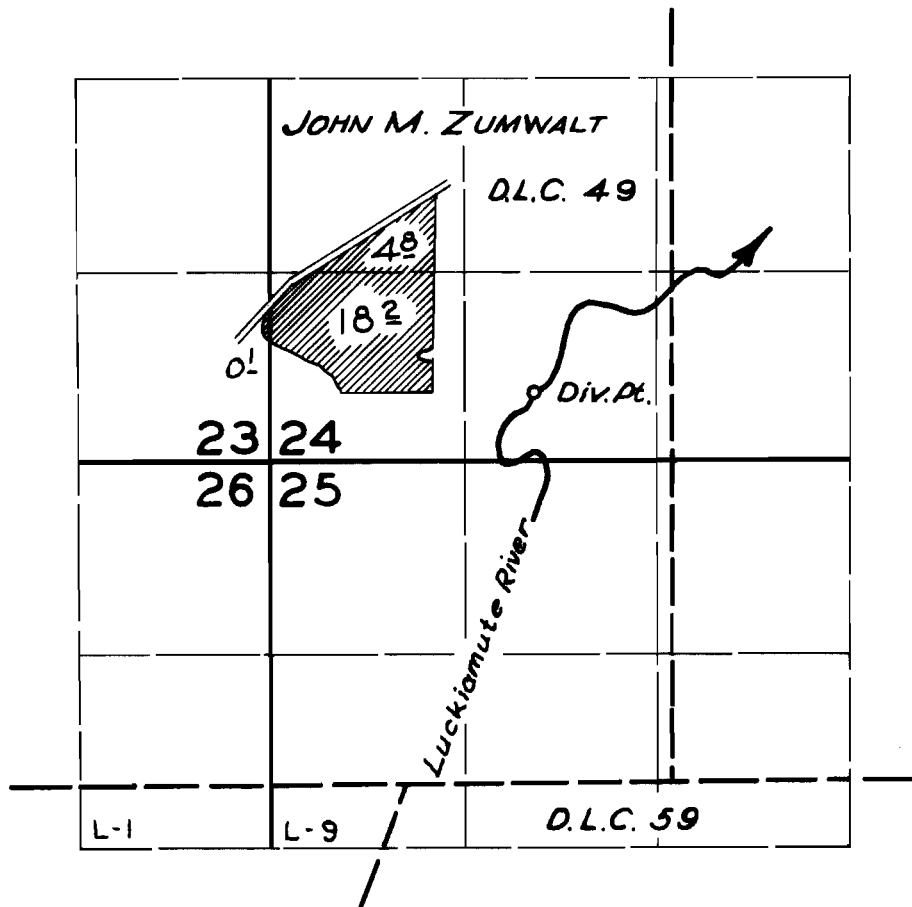

FINAL PROOF SURVEY
UNDER

Application No. 25278... Permit No. 21502.
IN NAME OF

DEWEY CUMMINS

Surveyed May 15, 1958, by R.H. Whitby.