


T.9S. R.6W.W.M.

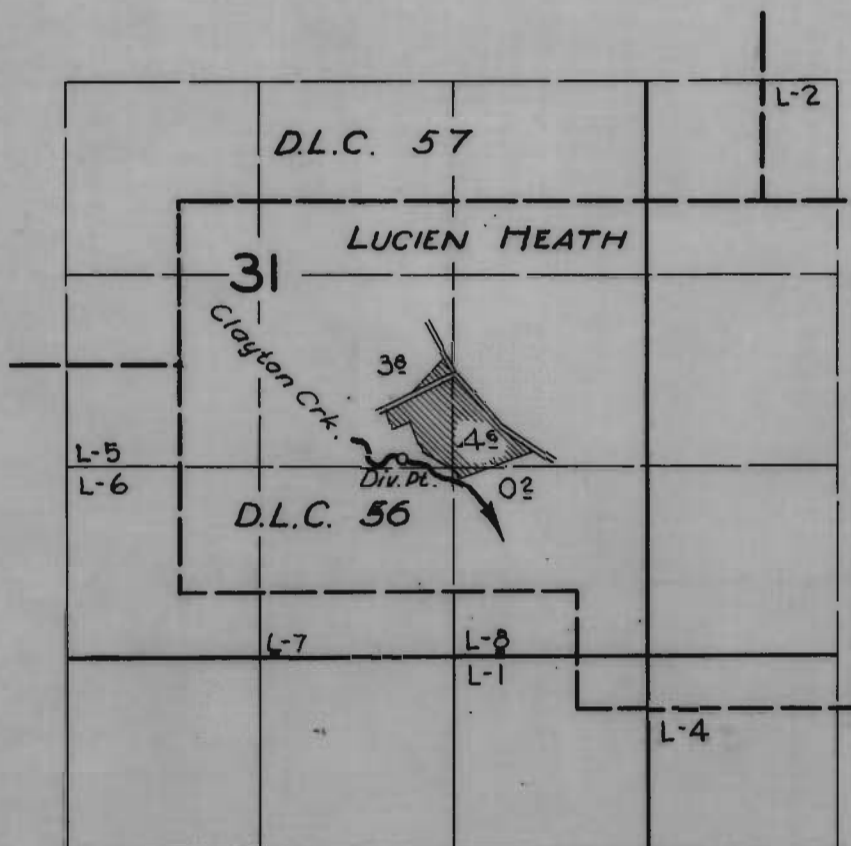

FINAL PROOF SURVEY
UNDER

Application No. 26770. Permit No. 21512...
IN NAME OF

PAUL SULLIVAN

Surveyed May 19, 1958, by R.H. Whitby