


T.13S. R.1E.W.M.

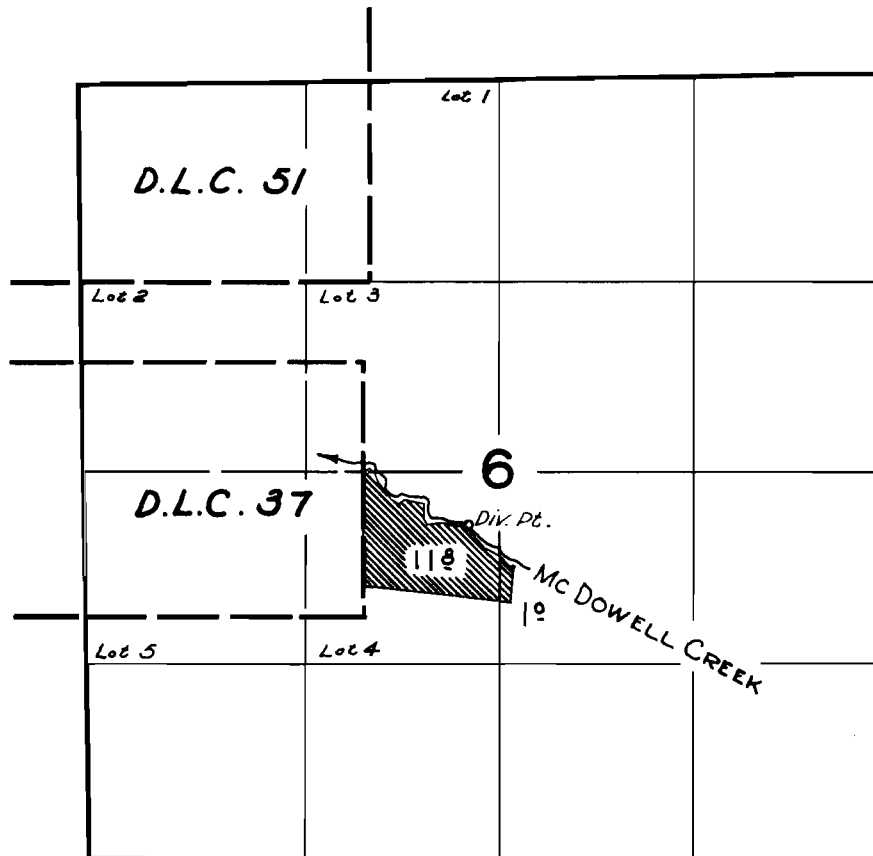

FINAL PROOF SURVEY
UNDER

Application No. 27371 Permit No. 21548
IN NAME OF

A. D. & NAOMI SWINK

Surveyed 11 Sept. 1958, by C.O. Bartels