


T.32 S.R.5 W.W.M.

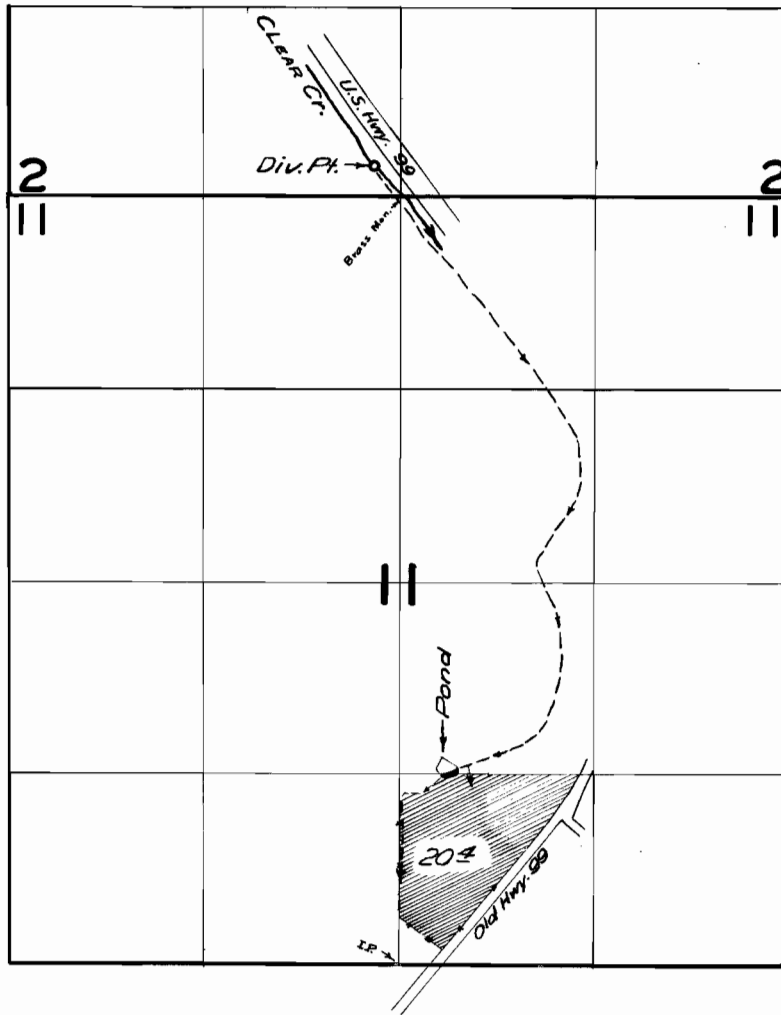

FINAL PROOF SURVEY UNDER

Application No. 27643 Permit No. 21774
IN NAME OF

LELAND S. JOHNS

Surveyed 8 Sept. 1958, by M. B. Sch