


T.4 S.R.3 E.W.M.

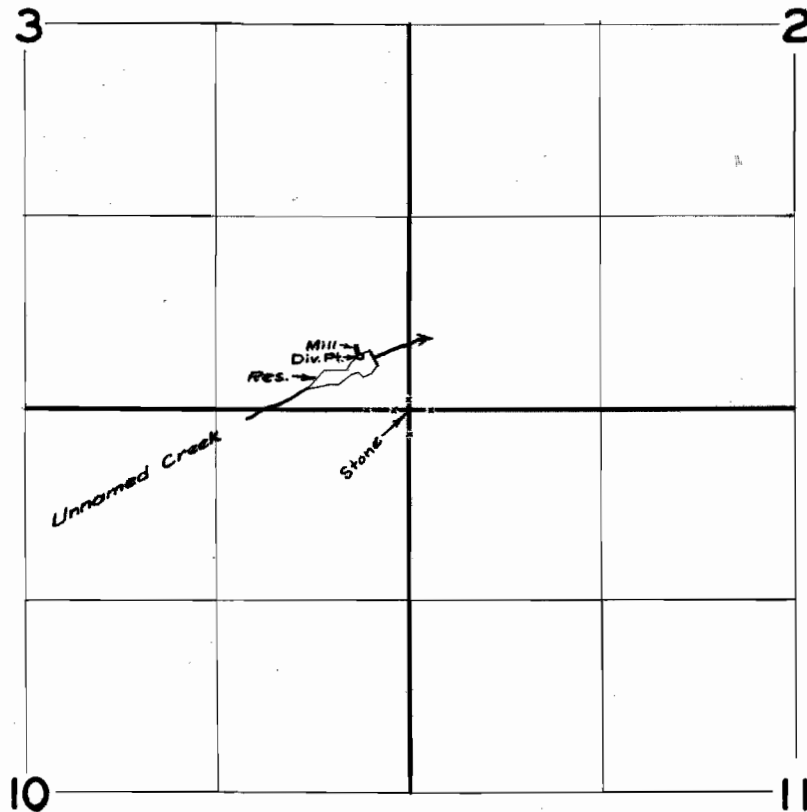

FINAL PROOF SURVEY
UNDER

Application No. R-27716 27717 Permit No. R-1435 21815
IN NAME OF

CHARLES & DORA STONE

Surveyed 22 Aug. 1958, by Tom R. Bish