


T. 3S. R. 3E. W.M.

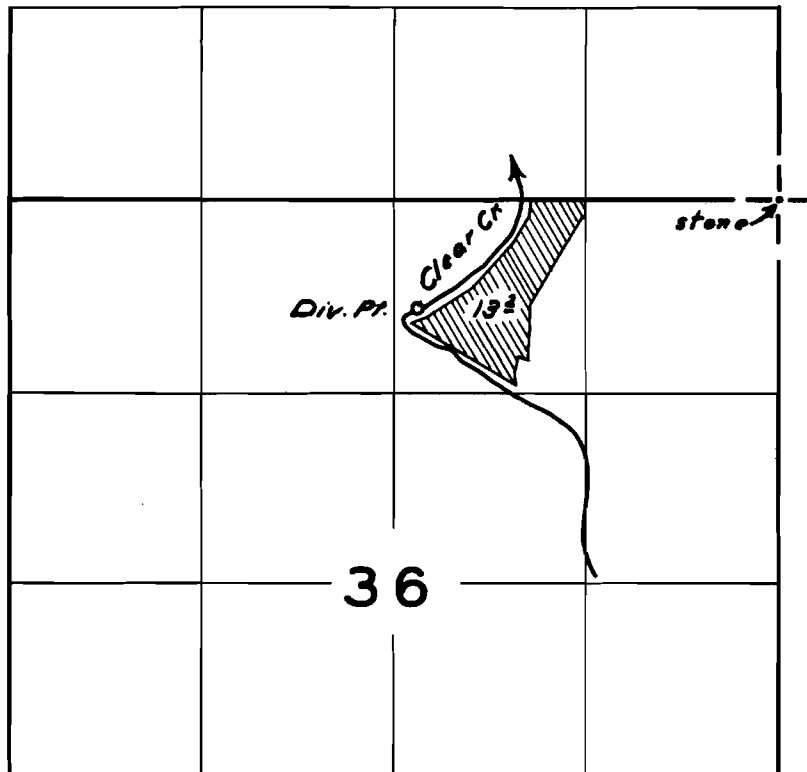

FINAL PROOF SURVEY
UNDER

Application No. 27512 Permit No. 21831
IN NAME OF

Wm. H. Tucker

Surveyed Aug. 28 1958, by W. N. Perry