


T. 1 S. R. 3 W. W. M.

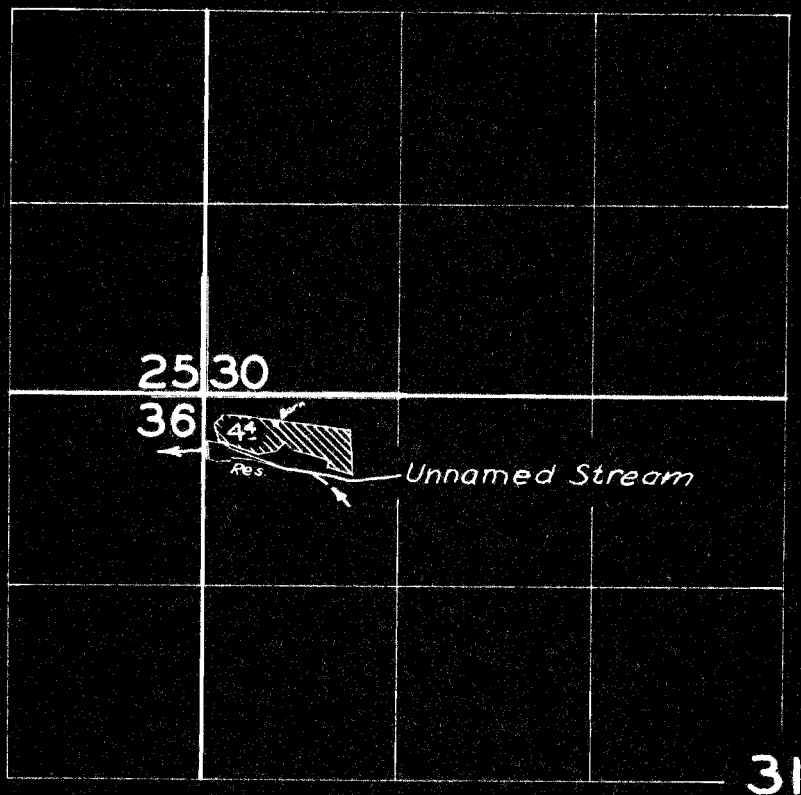

**FINAL PROOF SURVEY**  
UNDER

R-27789                      R-1447  
Application No. 27722 Permit No. 21836  
IN NAME OF

**T. R. GIBSON**

Surveyed 7 April 1958, by C. O. Bartels