


T.9S. R.6W.W.M.

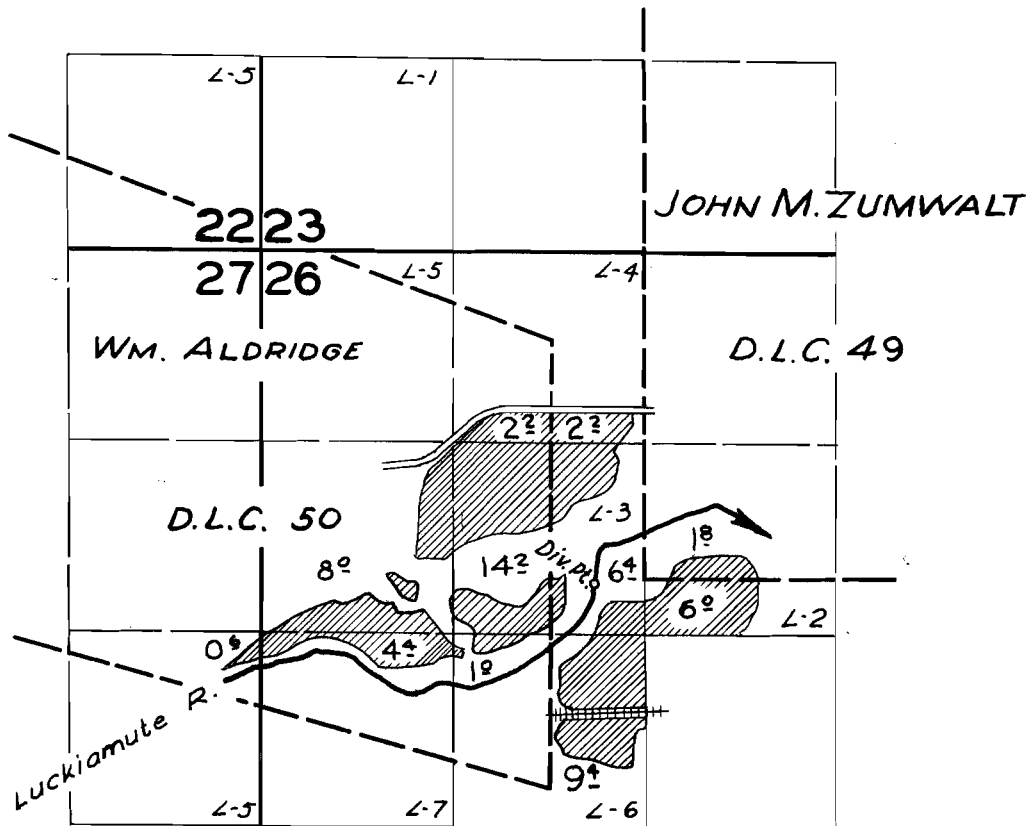

FINAL PROOF SURVEY
UNDER

Application No. 27728. Permit No. 21841.

IN NAME OF
LLOYD R. & MARY ISABEL WEISENSEE
MARGARET W. O'BRIEN

Surveyed May 19 1958, by R.H. Whitby