


T.14S. R. 7&8 W.W.M.

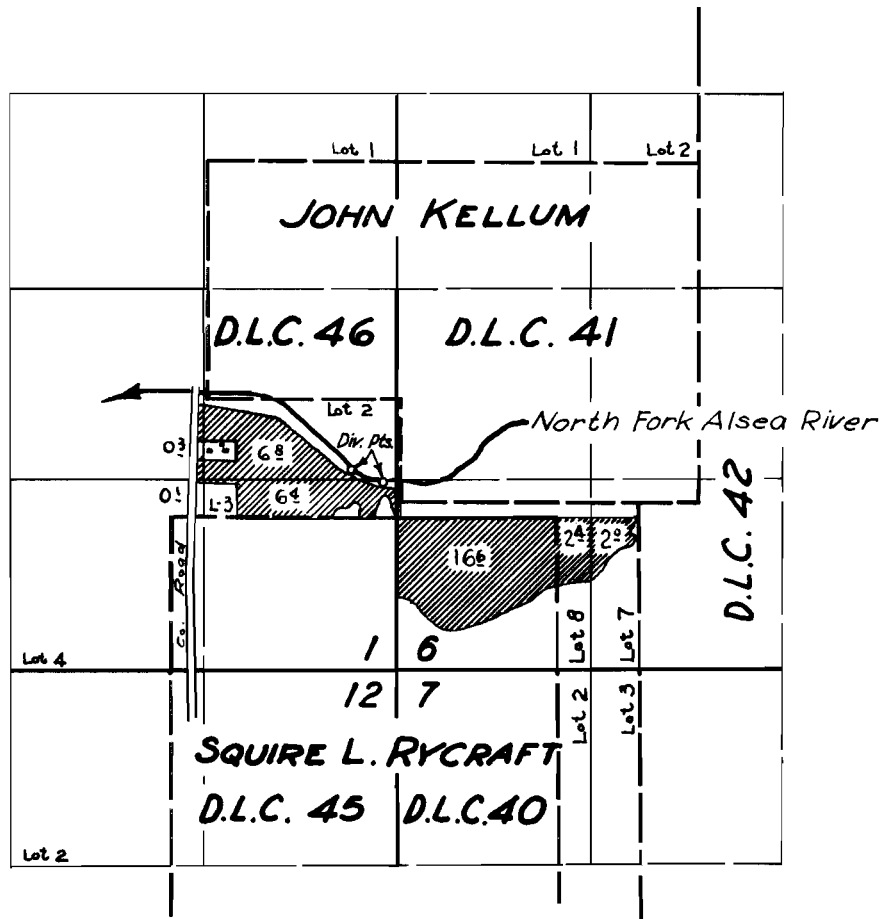

**FINAL PROOF SURVEY**  
UNDER

Application No. 27950. Permit No. 22004.  
IN NAME OF

**TRENA & A.A. BANTON**

Surveyed 1 Oct. 1958, by C.O. Bartels