


T.13S. R.7 W.W.M.

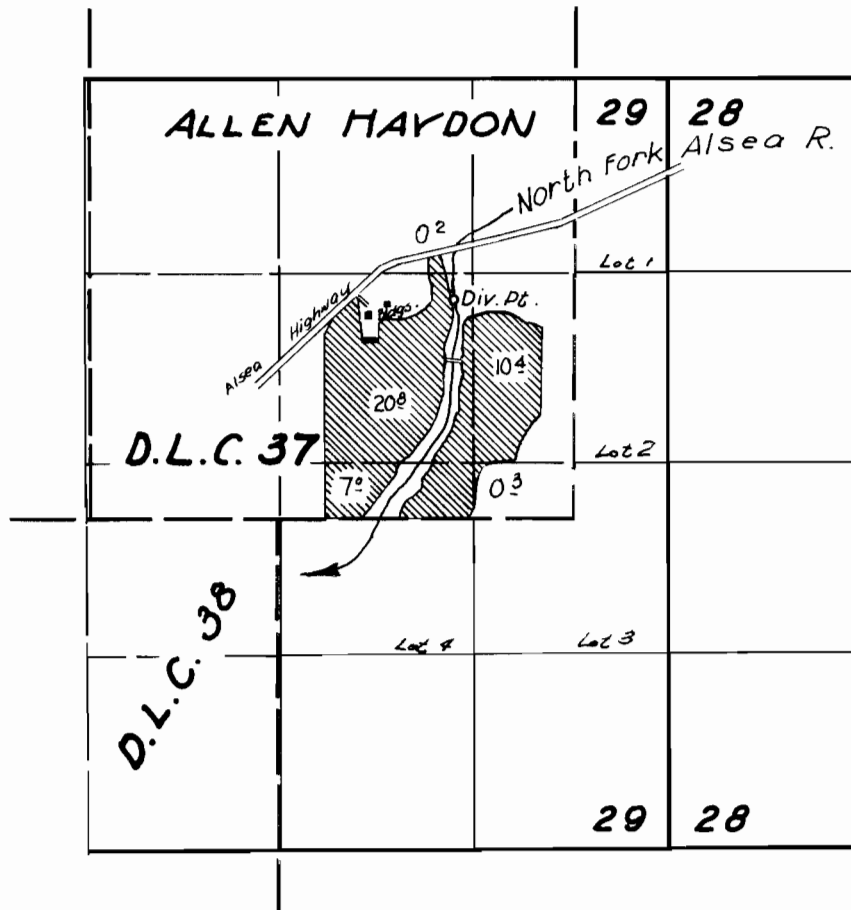

**FINAL PROOF SURVEY**  
UNDER

Application No. 27951 Permit No. 22005  
IN NAME OF

**CLARENCE DALE BROWNLEY**

Surveyed 2 Oct. 1958, by C.O. Bartels