


T.32 S.R.15 W.W.M.

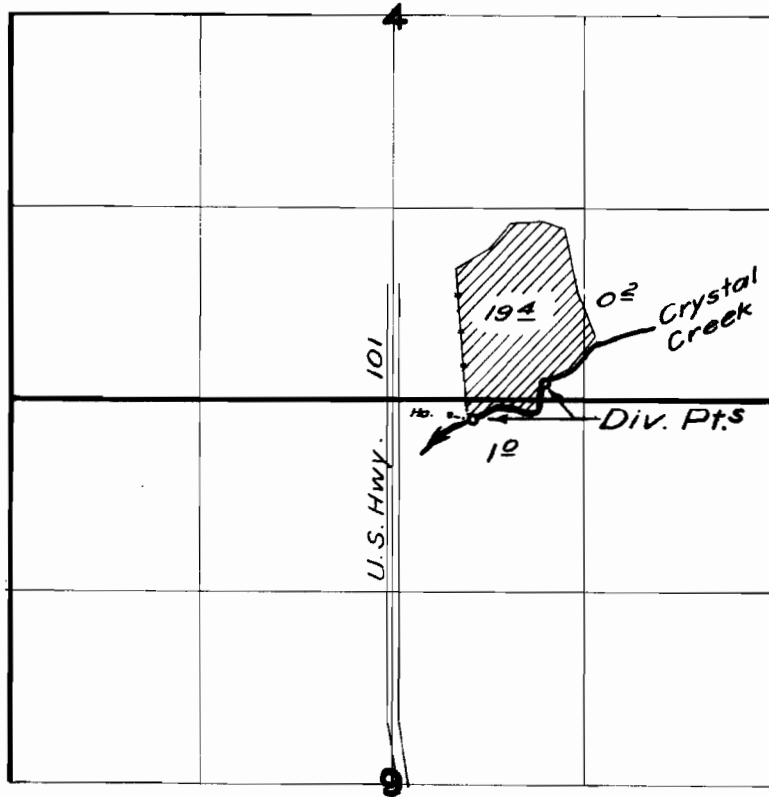

**FINAL PROOF SURVEY**  
UNDER

Application No. 28122 Permit No. 22135  
IN NAME OF

Ray B. & Gertrude E. Zumwalt

Surveyed 16 April 1958, by M. Bush