


T.4S. R.1E.W.M.

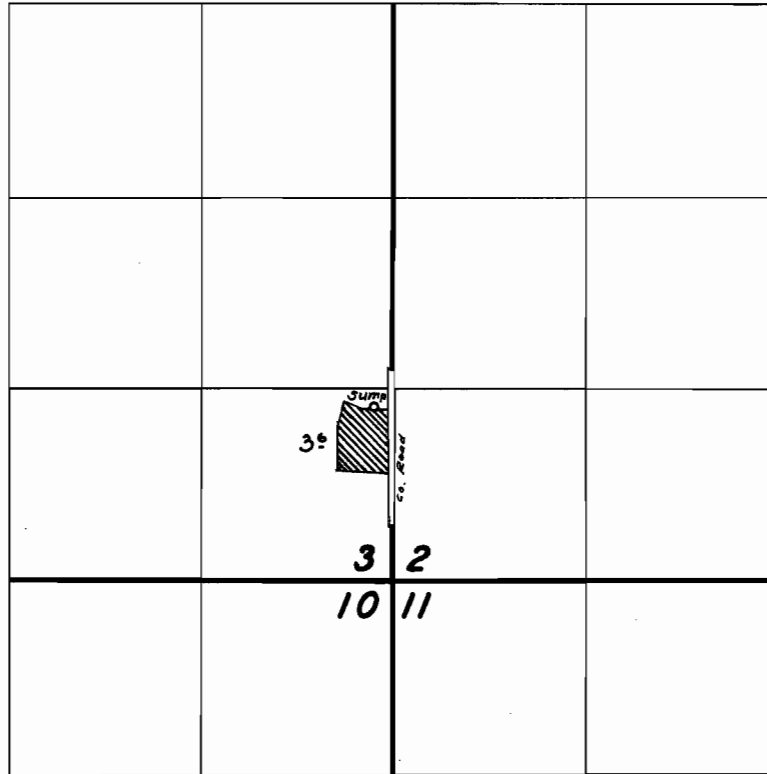

**FINAL PROOF SURVEY**  
UNDER

Application No. 28186... Permit No. 22180...  
IN NAME OF

**WARREN W. FREECE**

Surveyed 15 August 1958., by C. O. Bartels...