


T. 2S. R. 2E. W.M.

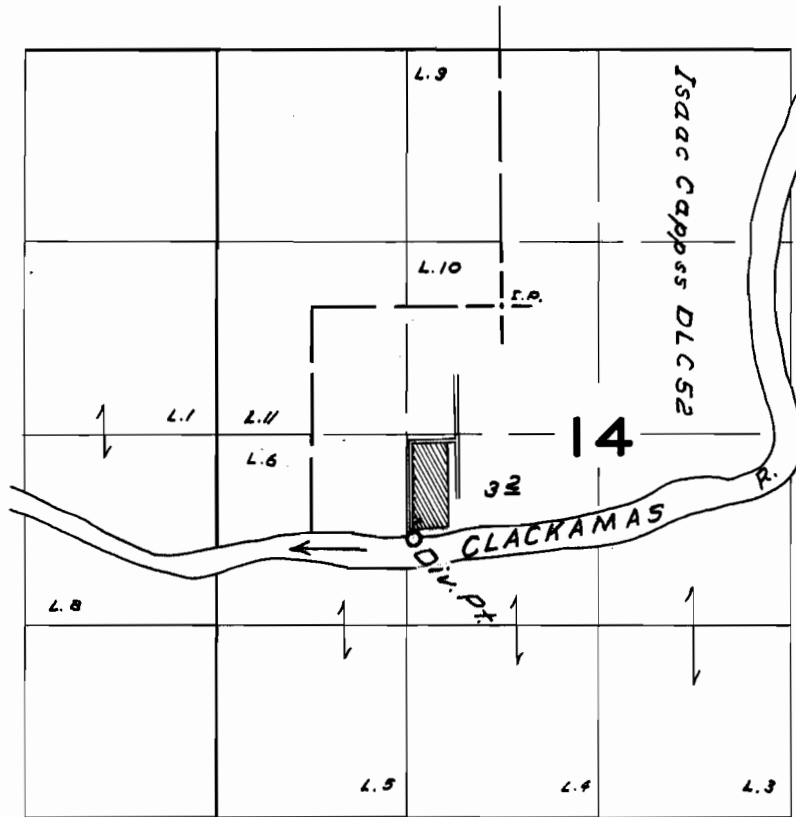

FINAL PROOF SURVEY
UNDER

Application No. 28212 Permit No. 22199
IN NAME OF

Walter M. & Barbara B. Novak

Surveyed July 11 1958, by W.N. Perry