


T. 3N. R. 3W. W.M.

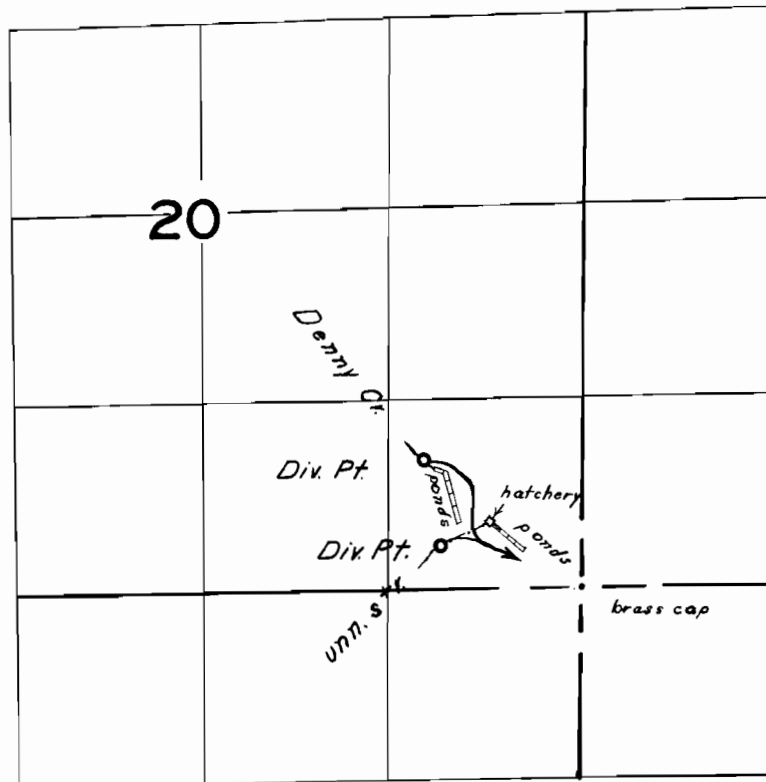

FINAL PROOF SURVEY
UNDER

Application No. 28279 Permit No. 22235
IN NAME OF

Edward Cook

Surveyed May 7 1958, by R.H. Whitby