


T.8S. R.6W.W.M.

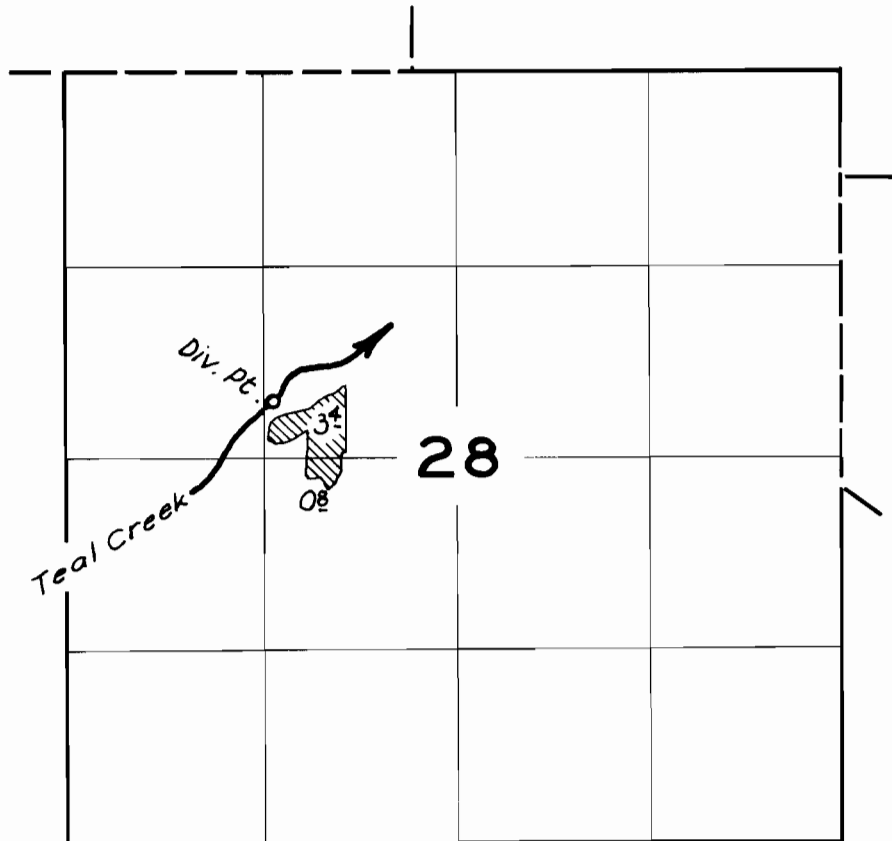

**FINAL PROOF SURVEY**  
UNDER

Application No. 28533. Permit No. 22328  
IN NAME OF

*JOSEPH F. CHAMBERLAIN*

Surveyed May 13, 1958, by R.H. Whitby.