


T. 13 S. R. 3 W. W.M.

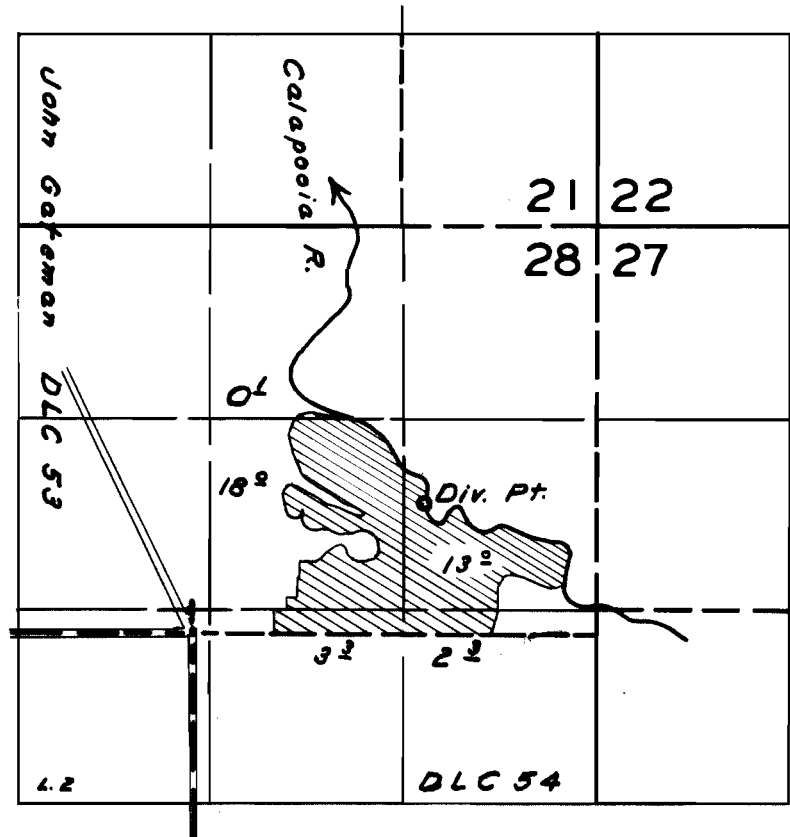

FINAL PROOF SURVEY
UNDER

Application No. 28565 Permit No. 22339
IN NAME OF

Omar E. & Phebe E. Falk

Surveyed Sept. 11, 1958, by W.N. Perry